



# Save Our Heritage

**Protecting the birthplace of the American Revolution,  
the cradle of the American Environmental Movement,  
and the home of the American Literary Renaissance.**

## Completion Report - Drawings

### Colonel James Barrett Farm

Prepared for

Minute Man National Historical Park / Barrett Farm  
National Park Service, Northeast Regional Office

Submitted by

Save Our Heritage, Inc.  
57 Main St., Concord, MA 01742



Prepared by

Frederic Detwiller, Historic Architect, New England Landmarks and  
Jim Cunningham, Barrett Farm Project Manager, Save Our Heritage, Inc

Beth Acly, Structures North, Inc

Paul Evans, Schnepel Woodworking and

Jeff Perley, Perley Engineering

Period of Restoration - From July 2005 to December 2012


Report Date – November 2016

# 1 Engineering Drawings

The drawings include:

- Architectural
- Structural
- Window
  - The Windows were made as detailed on D7.
  - Drawing D4a represents the Cap overhang/ reveal as fabricated.
  - Drawing 10 was a preliminary sketch. The Windows were made as detailed in the Revisions (D11 & D12).
- Drainage

Figure 1 Drawing A1 - Basement Plan .....	3
Figure 2 Drawing A2 – First Floor Plan As Built.....	4
Figure 3 Drawing A3 – Second Floor Plan As Built .....	6
Figure 4 Drawing A4 – Attic Floor Plan As Built.....	7
Figure 5 Drawing A5 – Section A-A’ .....	8
Figure 6 Drawing A6a – South Elevation.....	9
Figure 7 Drawing A7 – East Elevation.....	10
Figure 8 Drawing A8 – North Elevation .....	11
Figure 9 Drawing A9 – West Elevation.....	12
Figure 10 Drawing A10b – Window Trim Details .....	13
Figure 11 Drawing A11 – Frame Details.....	15
Figure 12 Drawing A12 – Kitchen/Bedroom Door .....	15
Figure 13 Drawing A13 – Kitchen Elevations.....	16
Figure 14 Drawing A14 – Kitchen Fireplace Details .....	17
Figure 15 Drawing E1 - Basement Electrical Plan .....	18
Figure 16 Drawing E2 - Attic Electrical Plan.....	19
Figure 17 Drawing S1 - Site .....	20
Figure 18 Structural Drawing S-0 – General Notes.....	21
Figure 19 Structural Drawing S-1 – First Floor Framing .....	22
Figure 20 Structural Drawing S-2 – Second Floor Framing.....	23
Figure 21 Structural Drawing S-3 – Attic Framing .....	24
Figure 22 Structural Drawing S-4 – Roof Framing .....	25
Figure 23 Structural Drawing S-5 – Sections and Details .....	26
Figure 24 Structural Drawing S-6 – Roof Truss.....	27
Figure 25 Window Drawing D1 - Types .....	28
Figure 26 Window Drawing D2 - Types .....	29
Figure 27 Window Drawing D3 – Type A .....	30
Figure 28 Window Drawing D3a – Type F .....	31
Figure 29 Window Drawing D4 .....	32
Figure 30 Window Drawing D4a – Type B.....	33
Figure 31 Window Drawing D5 – Cross Sections.....	34
Figure 32 Window Drawing D6 – Section Types.....	35
Figure 33 Window Drawing D7 – Window Profiles .....	36
Figure 34 Window Drawing D8 – Alternate A.....	37
Figure 35 Window Drawing D9 – Molding Profiles .....	38
Figure 36 Window Drawing D10 – Cellar.....	39
Figure 37 Window Drawing D11 - Cellar .....	40
Figure 38 Window Drawing D12 - Cellar .....	41
Figure 39 Drainage – Layout and Profile .....	42
Figure 40 Drainage – Layout and Profile – Detail Around House .....	43
Figure 41 Drainage – Ditch Detail.....	44

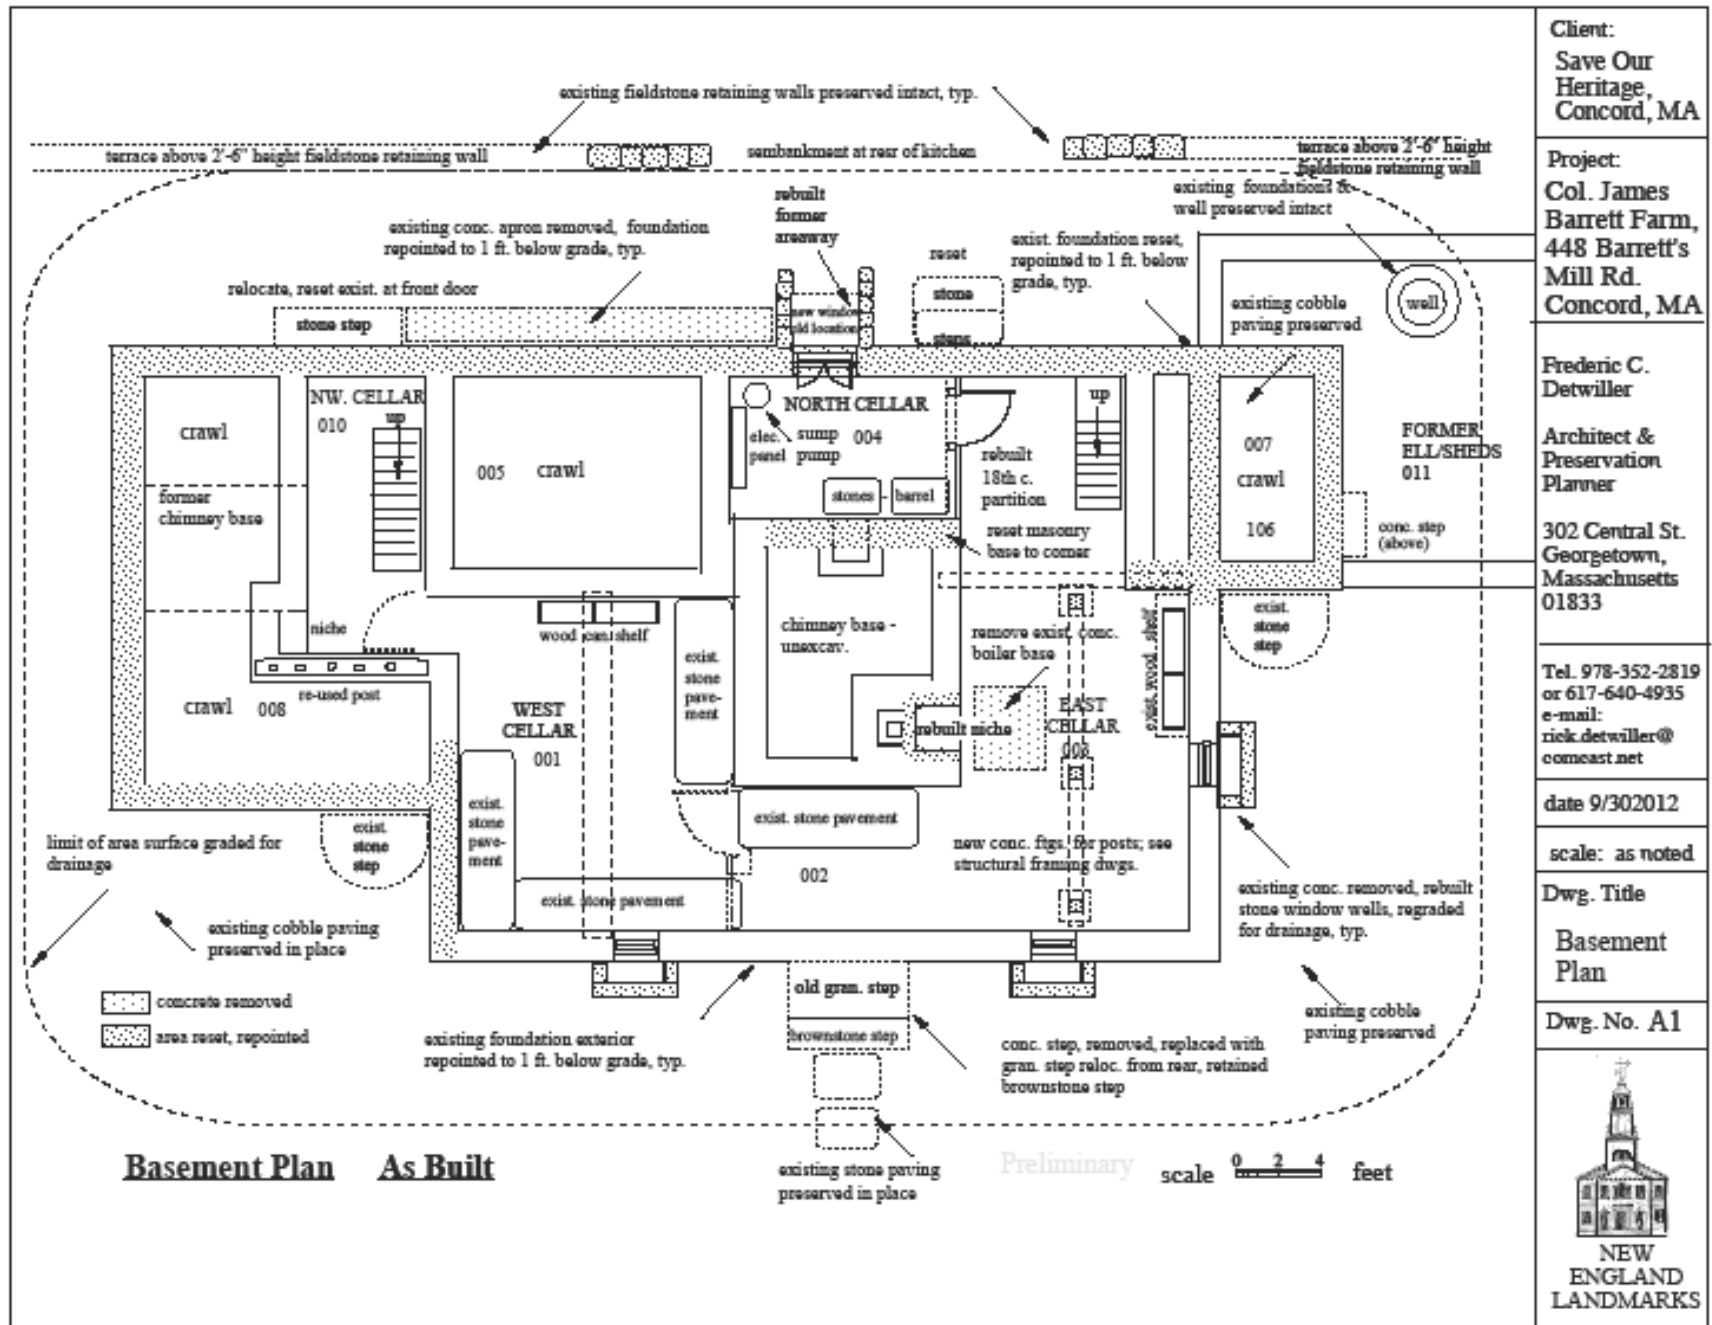

Client:  
Save Our  
Heritage,  
Concord, MA

Project:  
Col. James  
Barrett Farm,  
448 Barrett's  
Mill Rd.  
Concord, MA

Frederic C.  
Detwiler

Architect &  
Preservation  
Planner

302 Central St.  
Georgetown,  
Massachusetts  
01833

Tel. 978-352-2819  
or 617-640-4935  
e-mail:  
rick.detwiler@  
comcast.net

date 9/30/2012

scale: as noted

Dwg. Title  
Basement  
Plan

Dwg. No. A1



Figure 1 Drawing A1 - Basement Plan

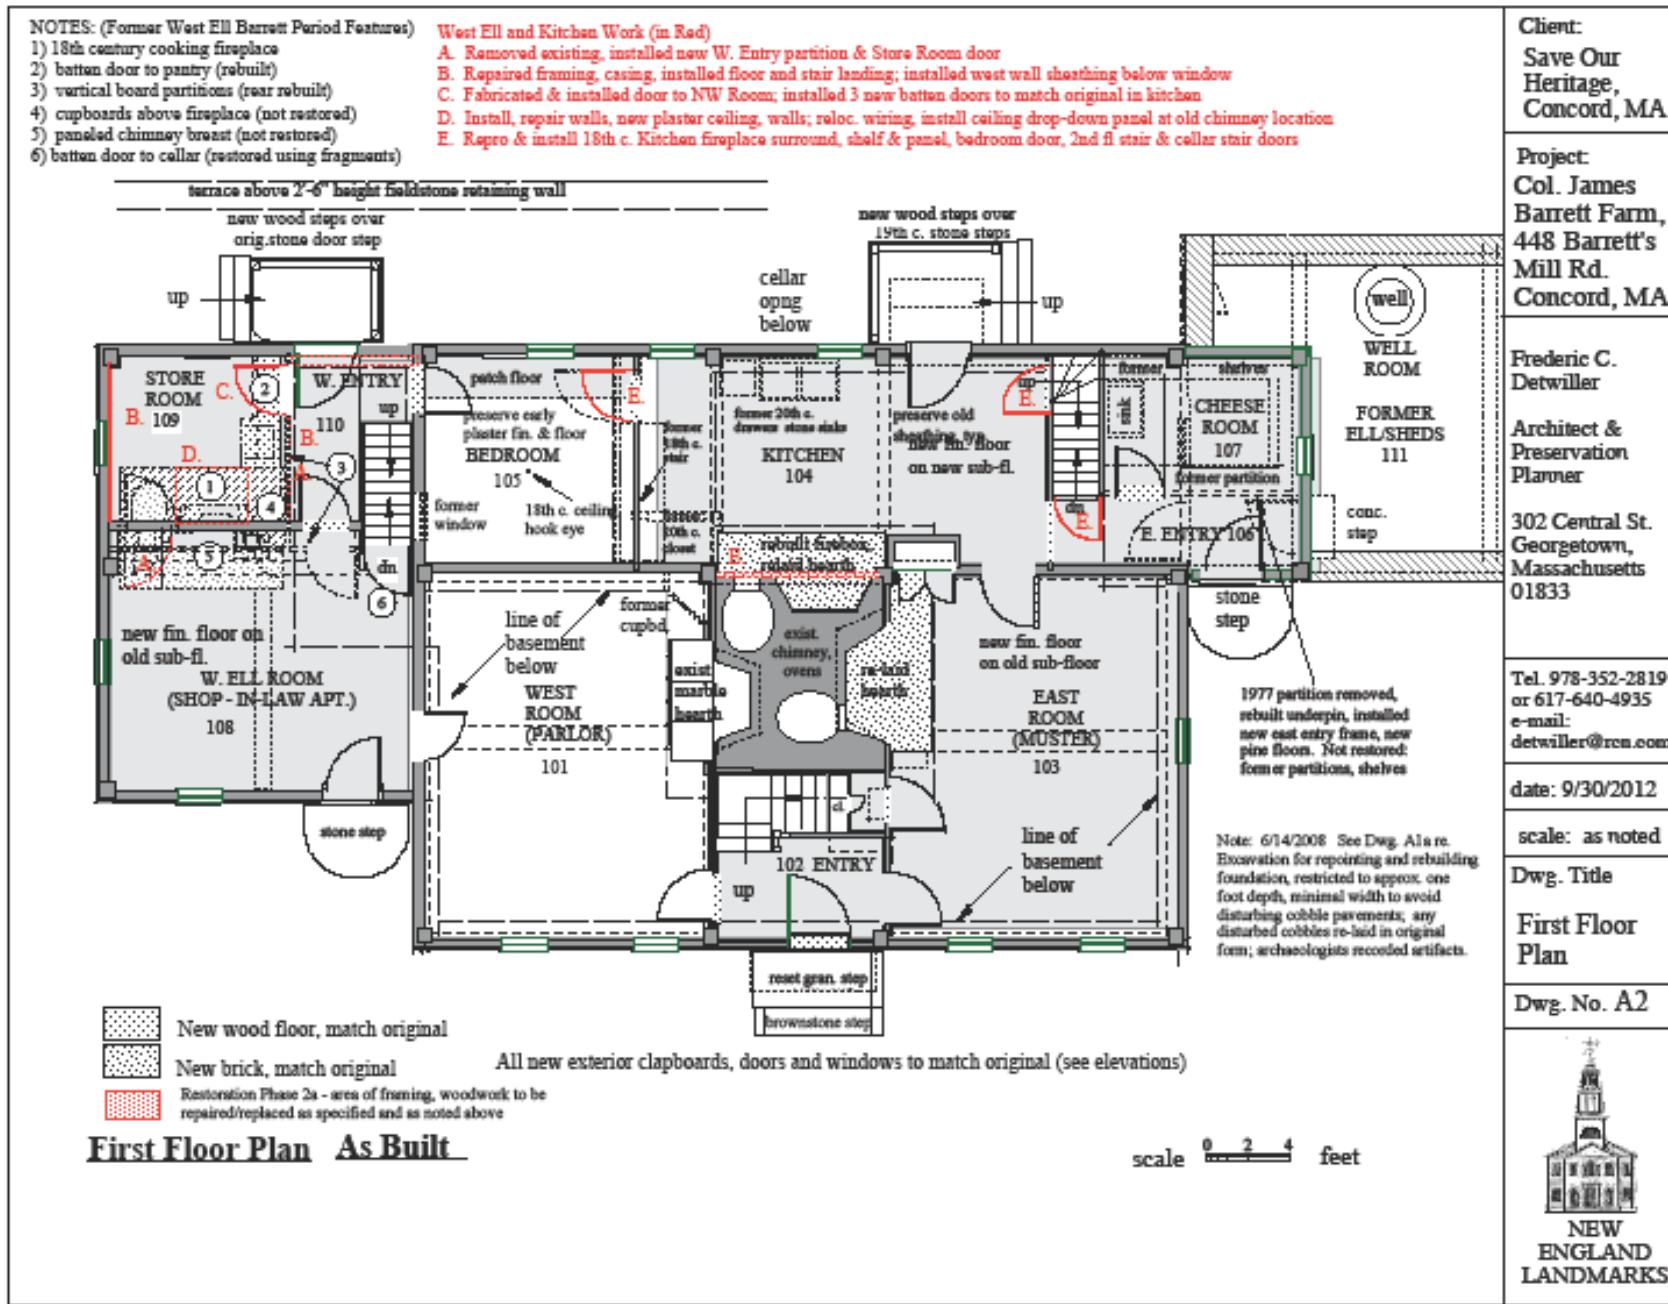


Figure 2 Drawing A2 – First Floor Plan As Built

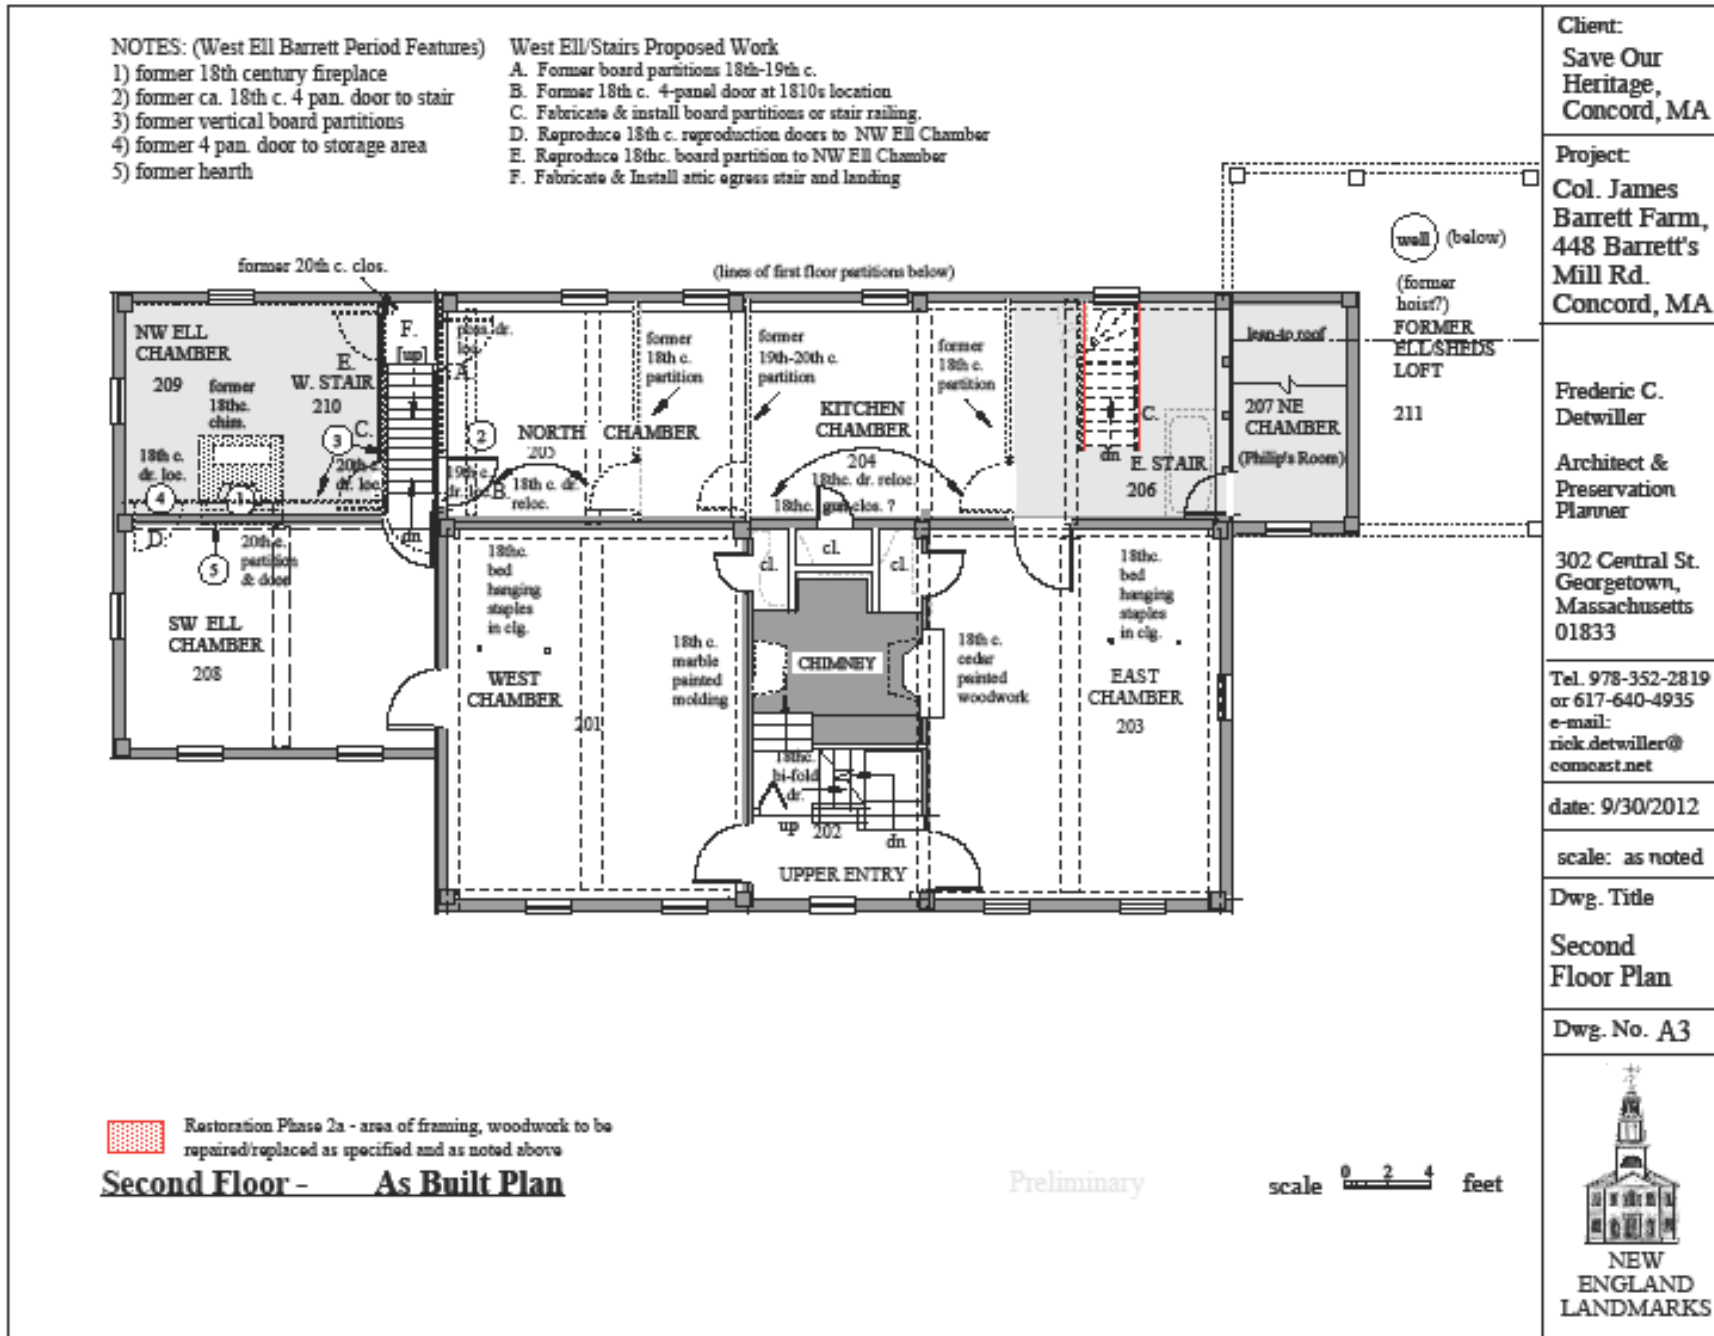


Figure 3 Drawing A3 – Second Floor Plan As Built

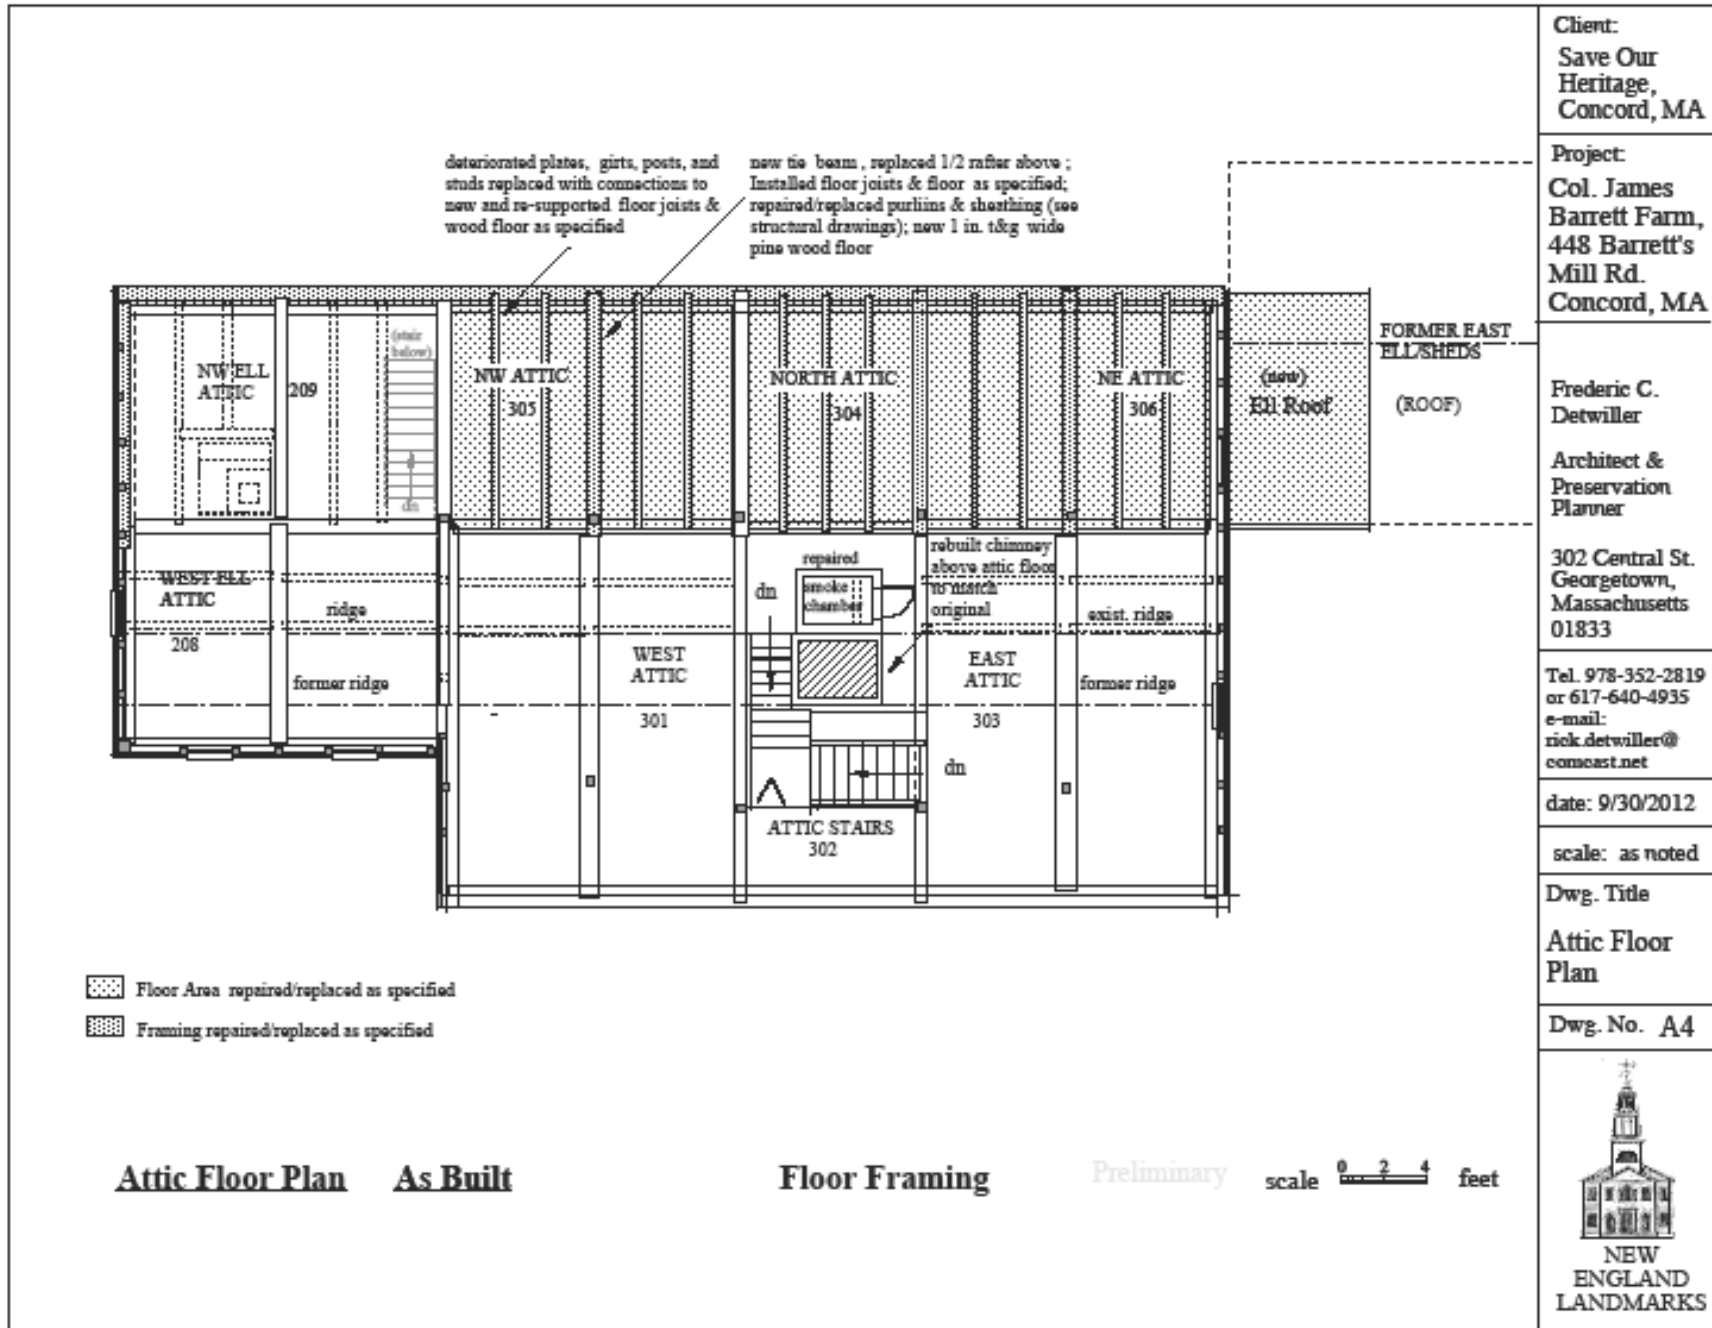


Figure 4 Drawing A4 – Attic Floor Plan As Built

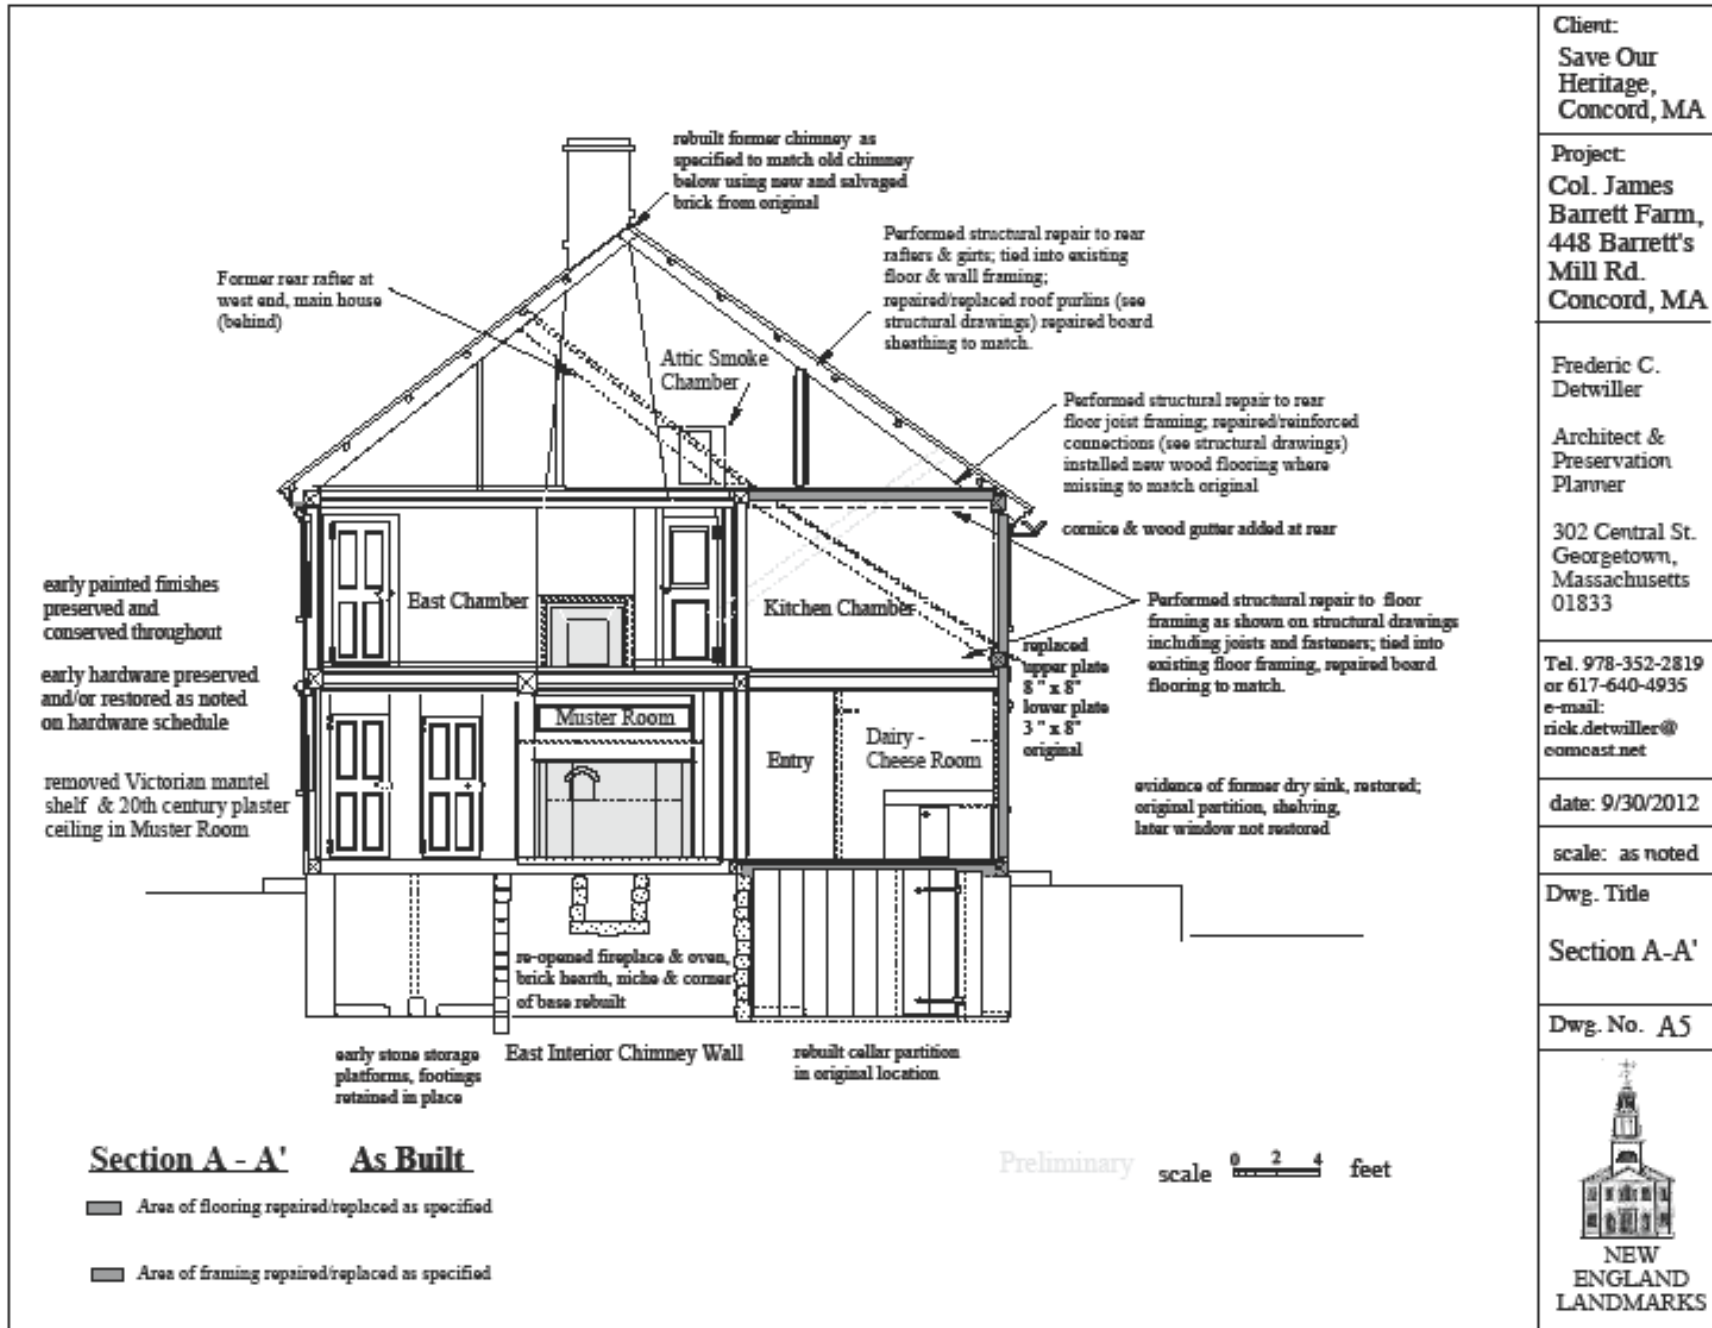


Figure 5 Drawing A5 – Section A-A'


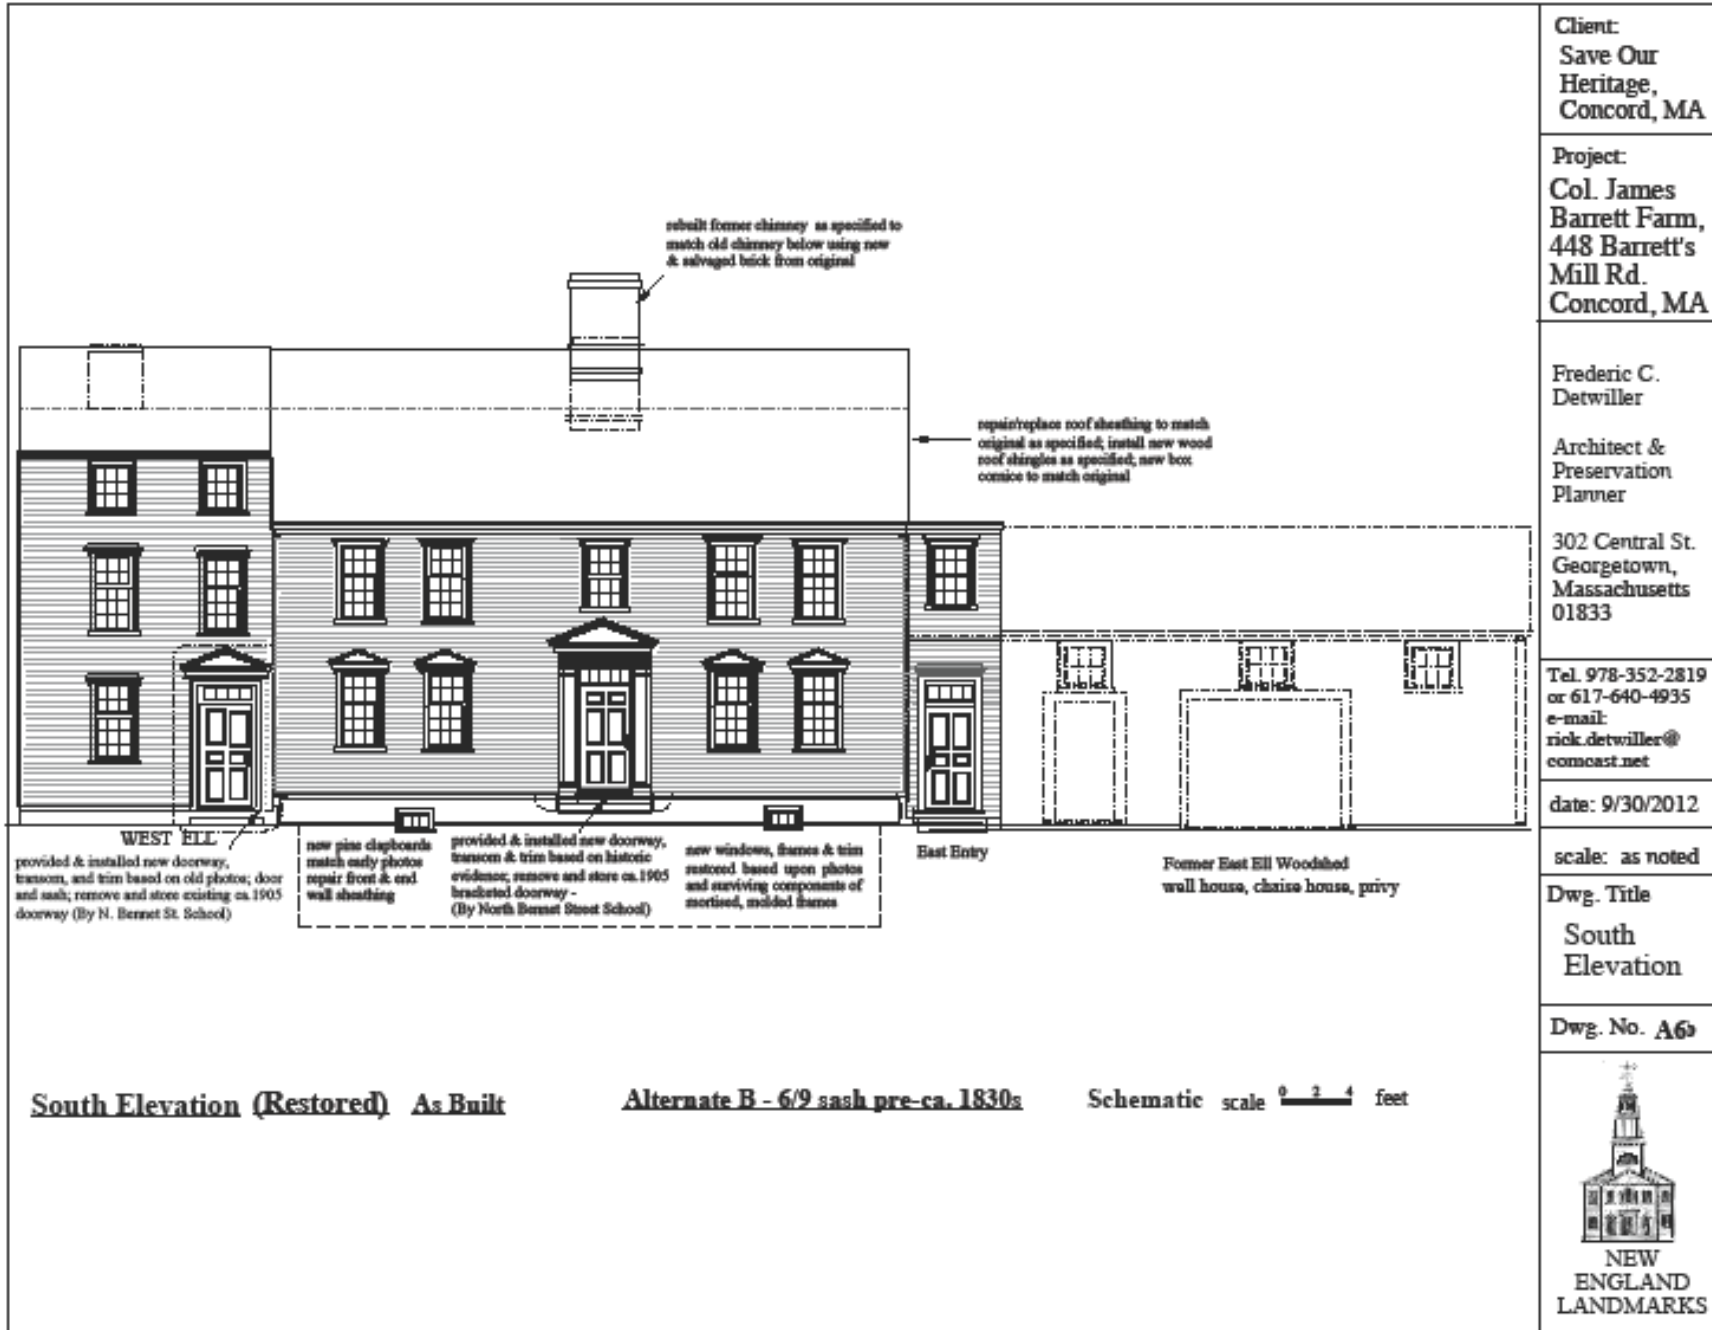




Figure 6 Drawing A6a – South Elevation

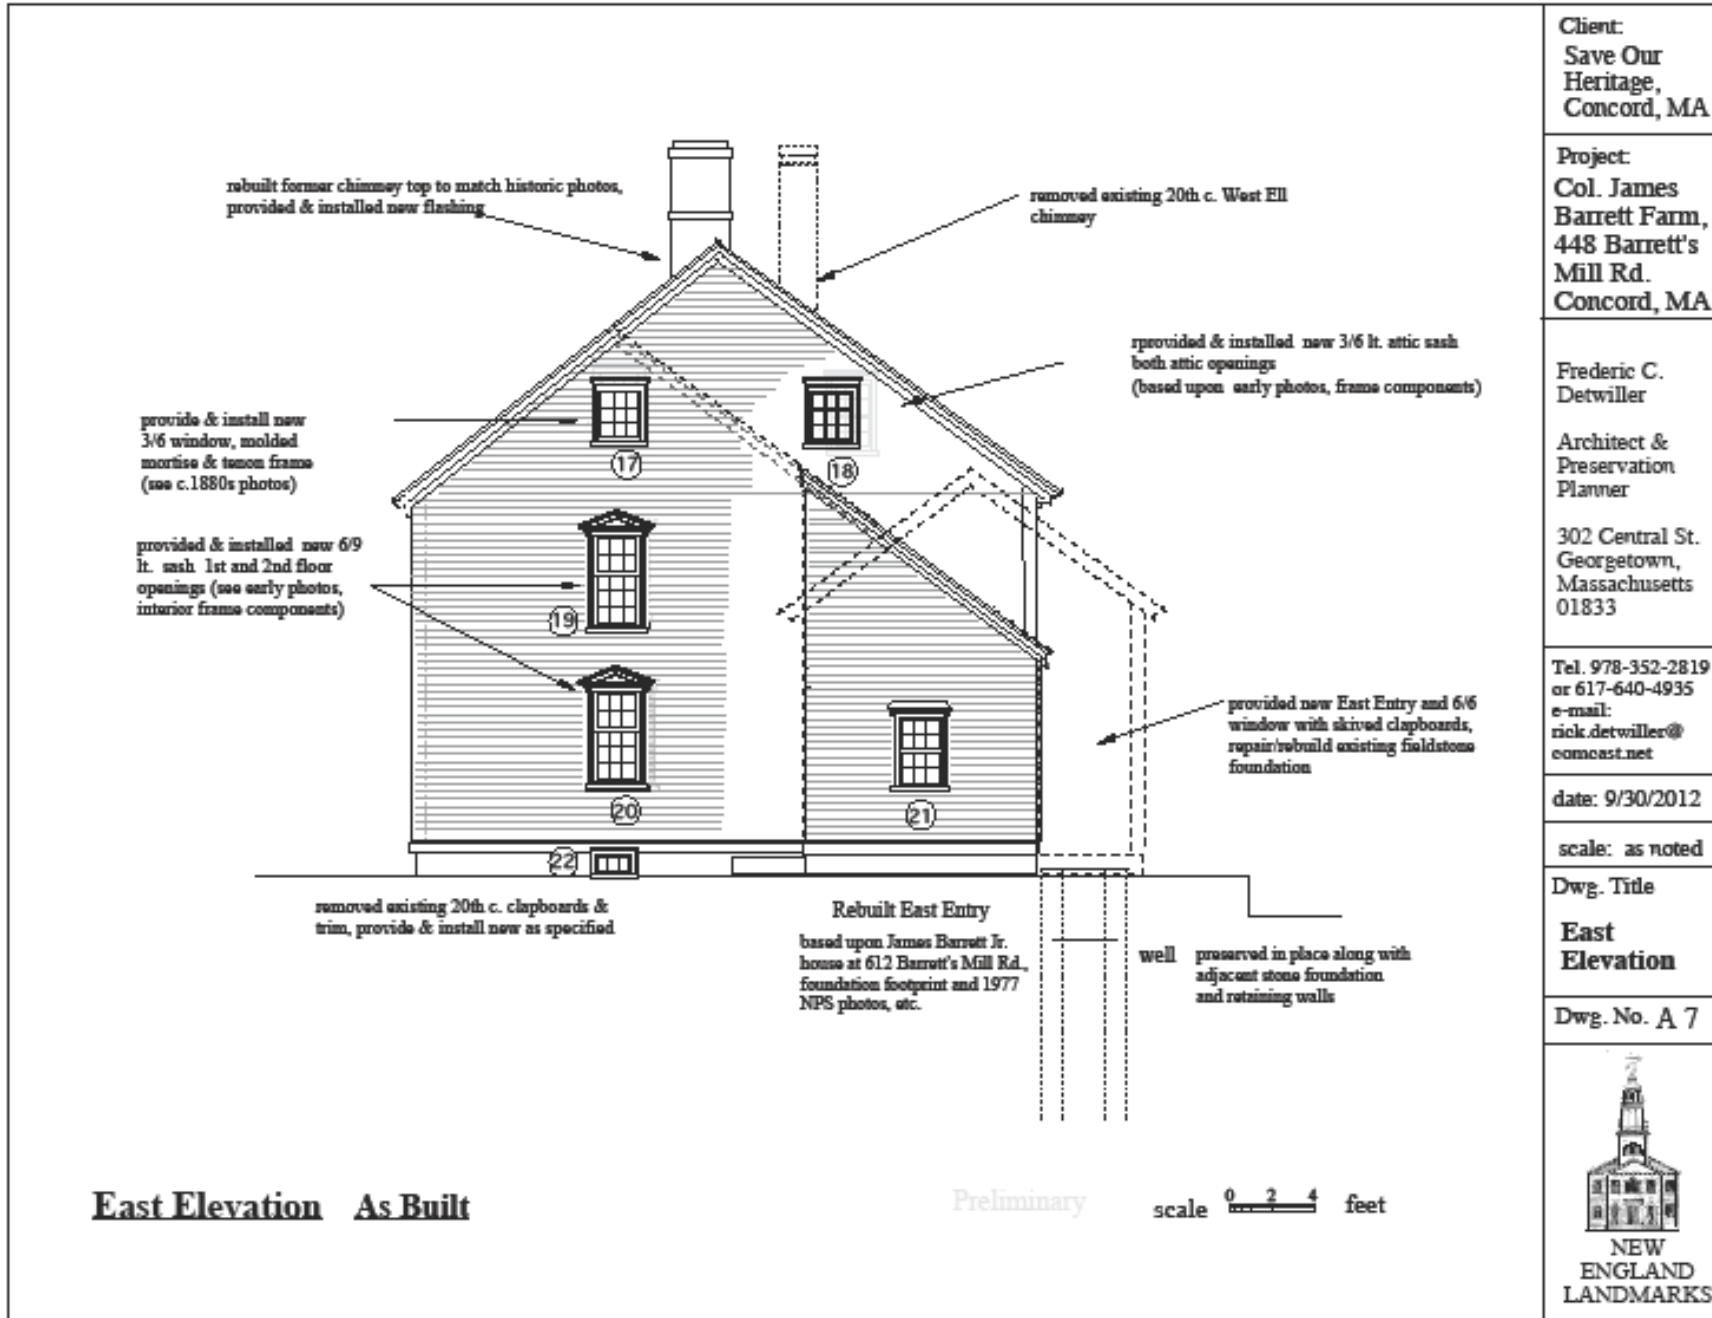

Client:  
Save Our  
Heritage,  
Concord, MA

Project:  
Col. James  
Barrett Farm,  
448 Barrett's  
Mill Rd.  
Concord, MA

Frederic C.  
Detwiller  
Architect &  
Preservation  
Planner  
302 Central St.  
Georgetown,  
Massachusetts  
01833

Tel. 978-352-2819  
or 617-640-4935  
e-mail:  
rick.detwiller@  
comcast.net

date: 9/30/2012

scale: as noted

Dwg. Title  
**East  
Elevation**

Dwg. No. A 7



Figure 7 Drawing A7 – East Elevation

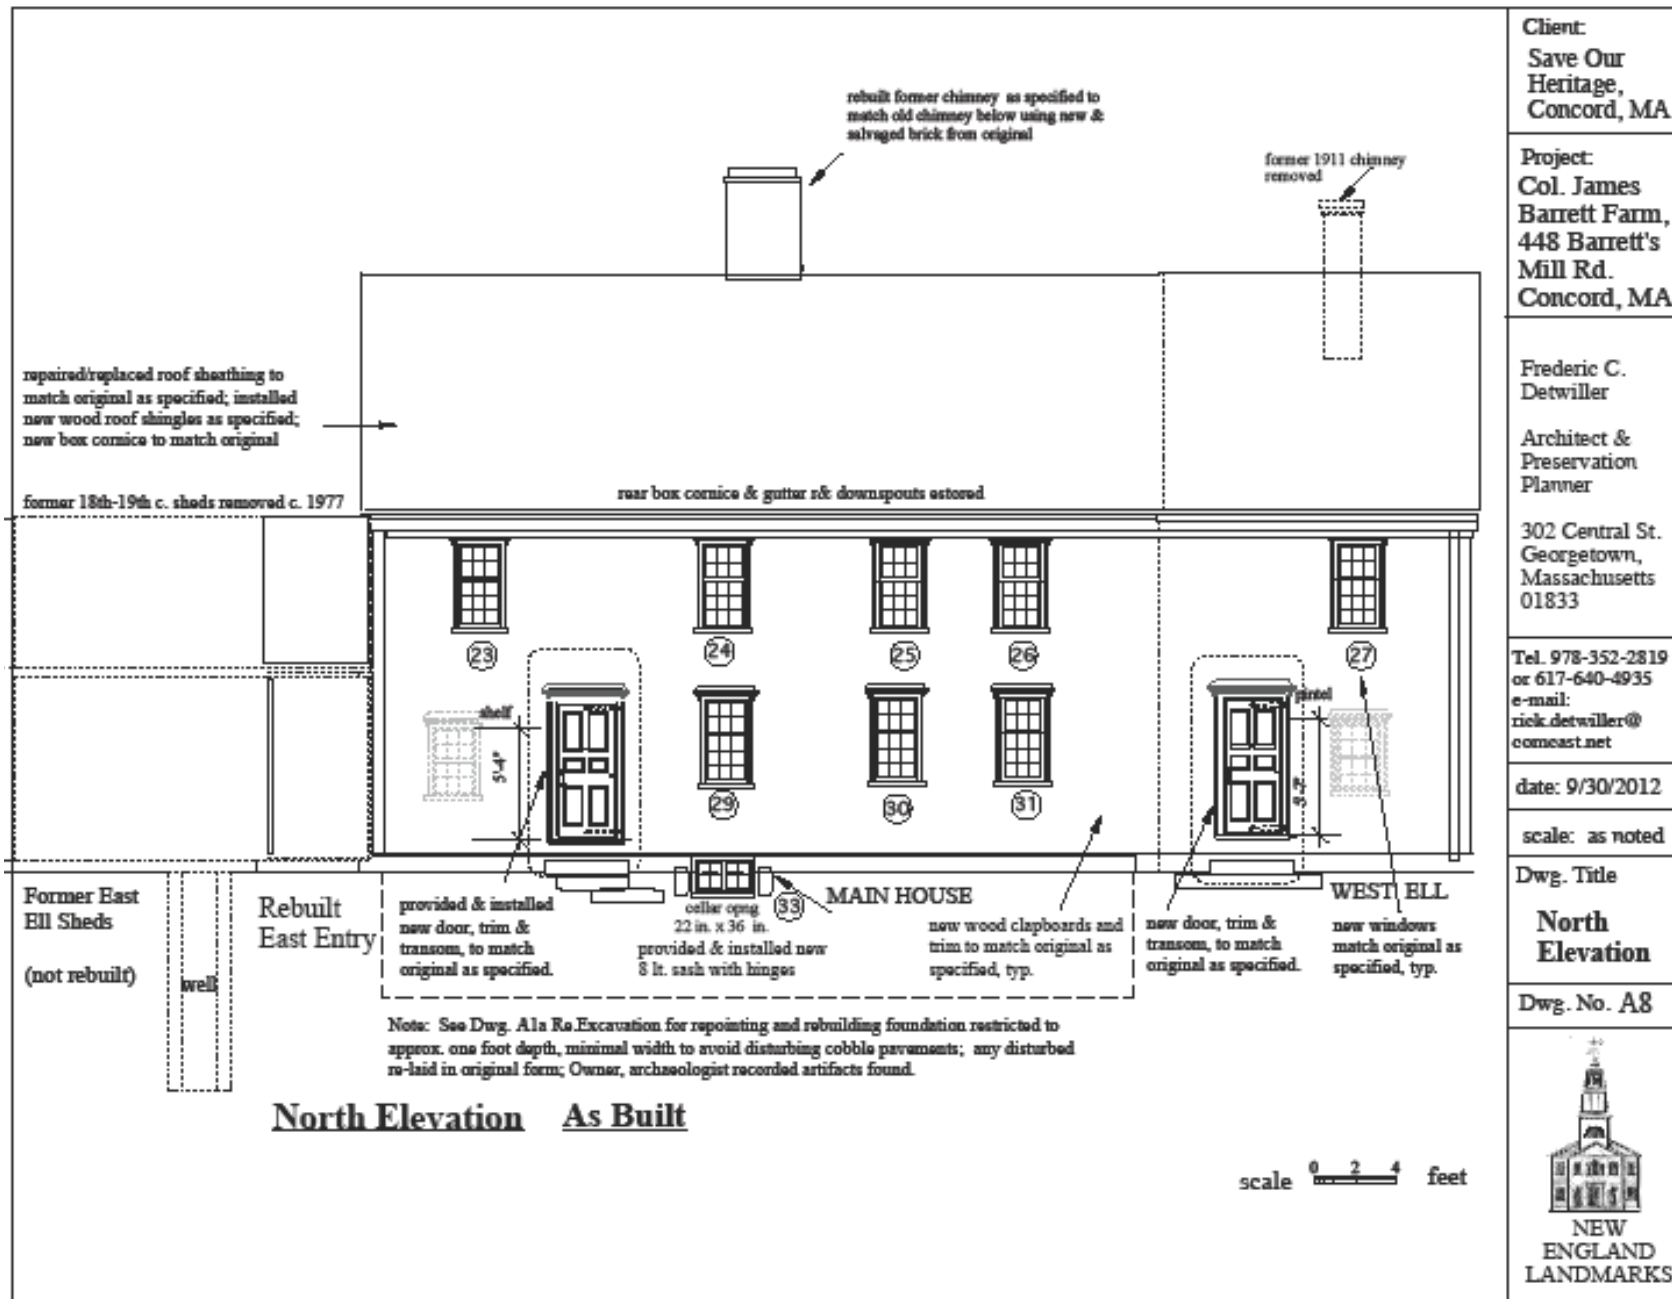


Figure 8 Drawing A8 – North Elevation

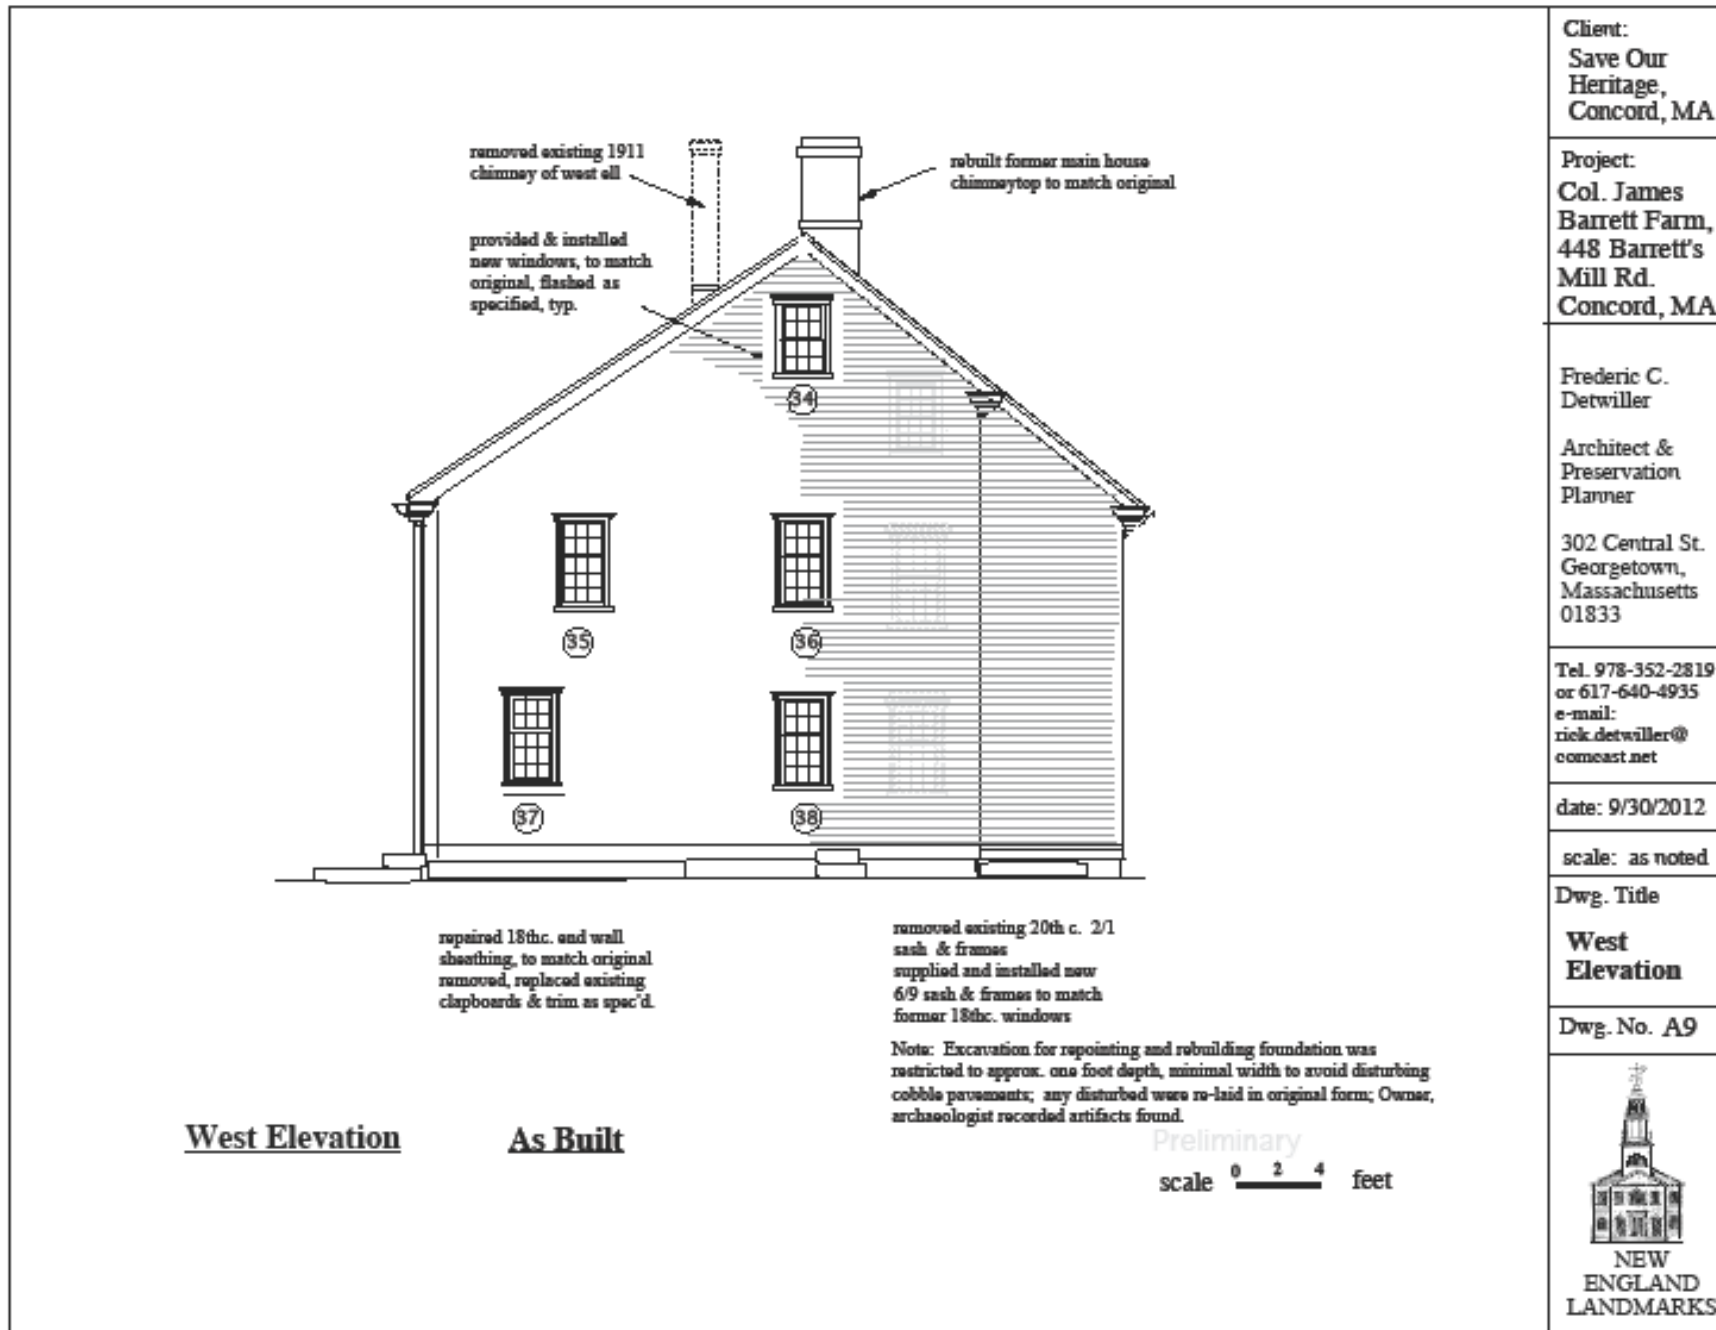
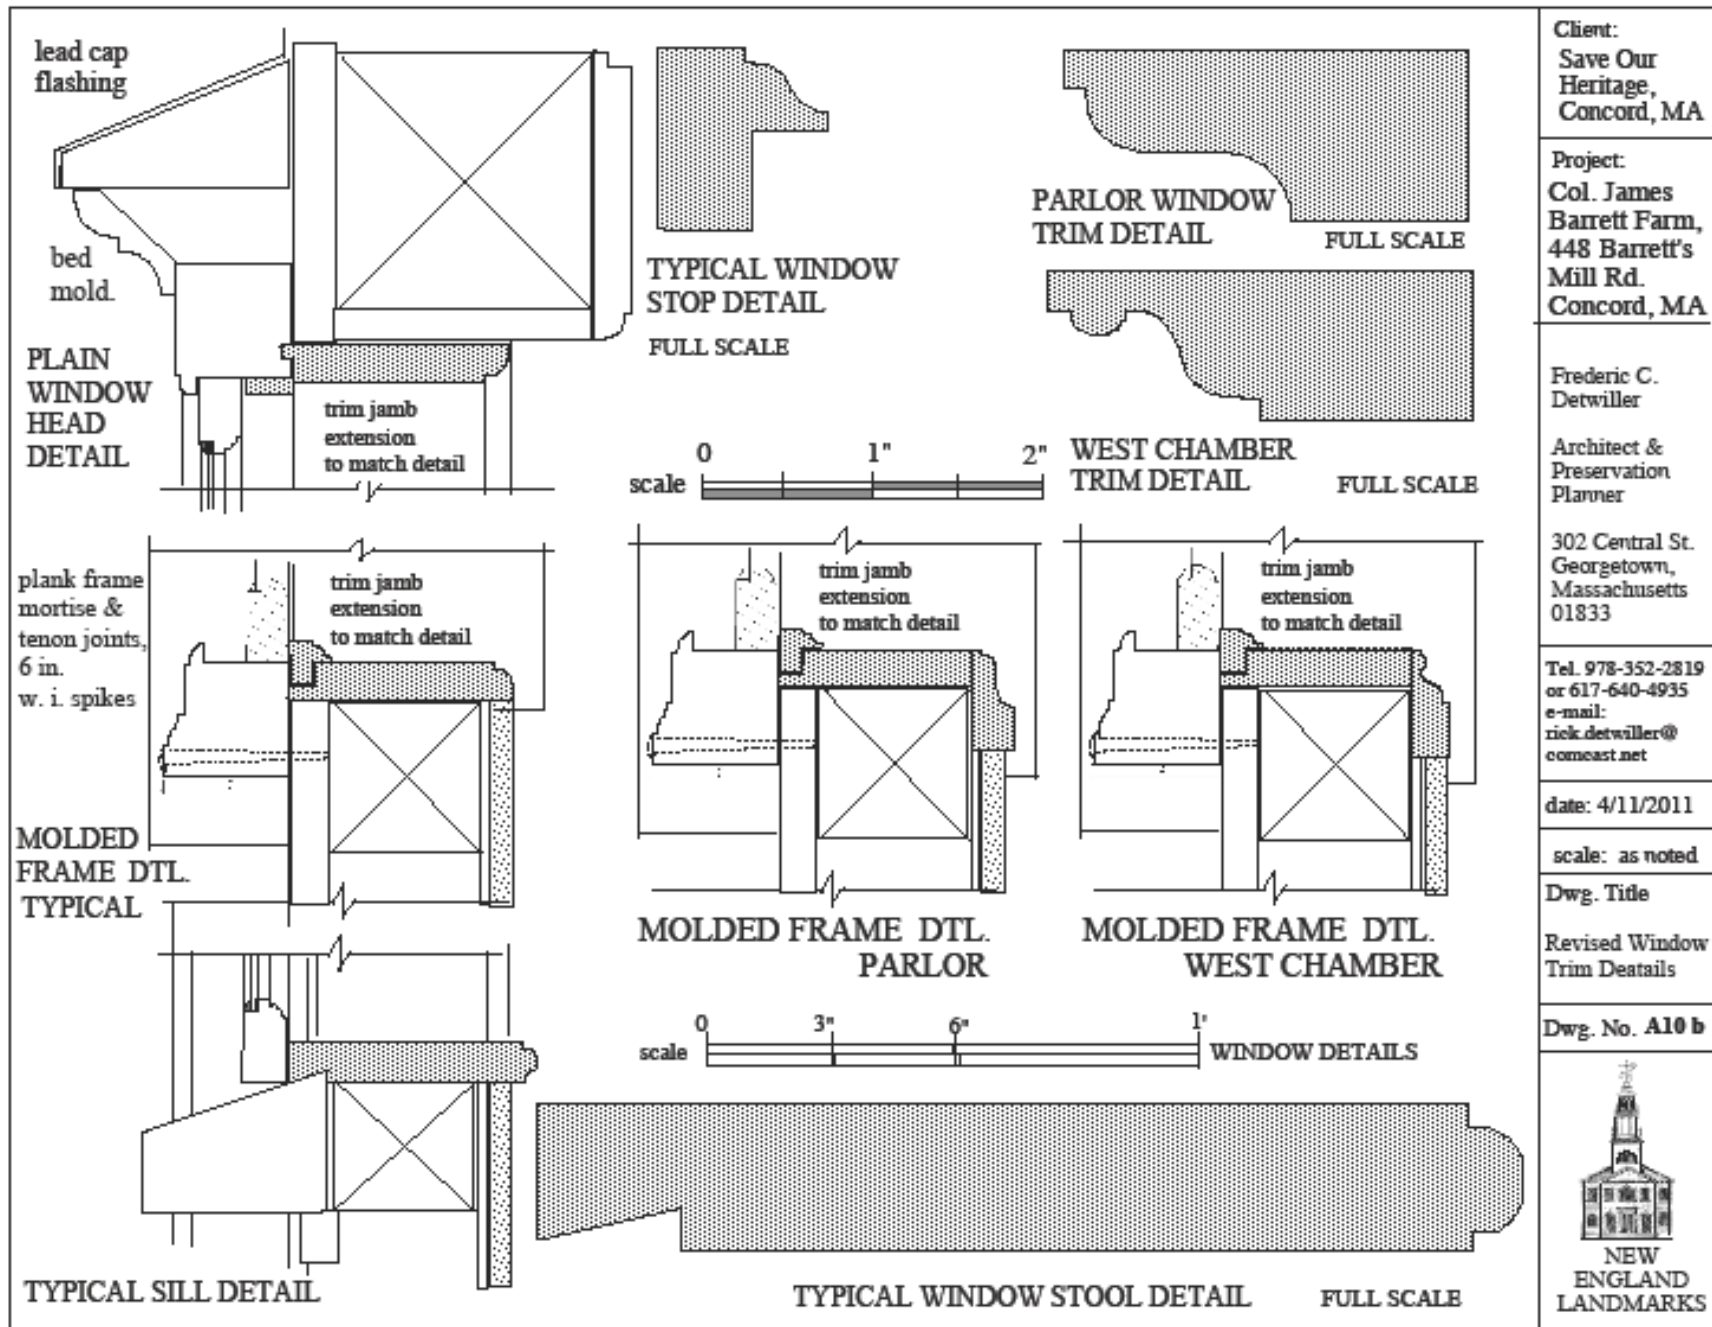


Figure 9 Drawing A9 – West Elevation



**Figure 10 Drawing A10b – Window Trim Details**

			<p>Client: Save Our Heritage, Concord, MA</p>
<p><b>Rafter Foot Repair</b></p>	<p><b>Bridled Scarf Joint, Plate Repair</b></p>	<p><b>Rafter Tie Gusset Connector</b></p>	<p>Project: Col. James Barrett Farm, 448 Barrett's Mill Rd. Concord, MA</p>
			<p>Frederic C. Detwiller Architect &amp; Preservation Planner 302 Central St. Georgetown, Massachusetts 01833</p>
<p><b>Plate Protection for Cabling</b></p>	<p><b>Stud &amp; Girt Joint Details</b></p>	<p><b>Beam Face Repair</b></p>	<p>Tel. 978-352-2819 or 617-640-4935 e-mail: rick.detwiller@comcast.net</p>
			<p>date: 3/7/2008</p>
<p><b>Blind Mortise at Sill, Corner Post</b></p>	<p><b>Beam End Repair</b></p>	<p><b>Post Scarf Joint Repair</b></p>	<p>scale: as noted</p>
<p><b>Framing Details</b></p>		<p>approx. scale  feet</p>	<p>Dwg. Title <b>Framing Details</b></p>
<p>Note: See Structural drawings for additional details. These Joinery Details adapted from J.A. Sobon's American Timber Joinery, Timber Framers Guild</p>	<p><b>Post Base &amp; Free Tenon Repairs</b></p>	<p>Dwg. No. A11</p>	<p>NEW ENGLAND LANDMARKS</p>

Figure 11 Drawing A11 – Frame Details

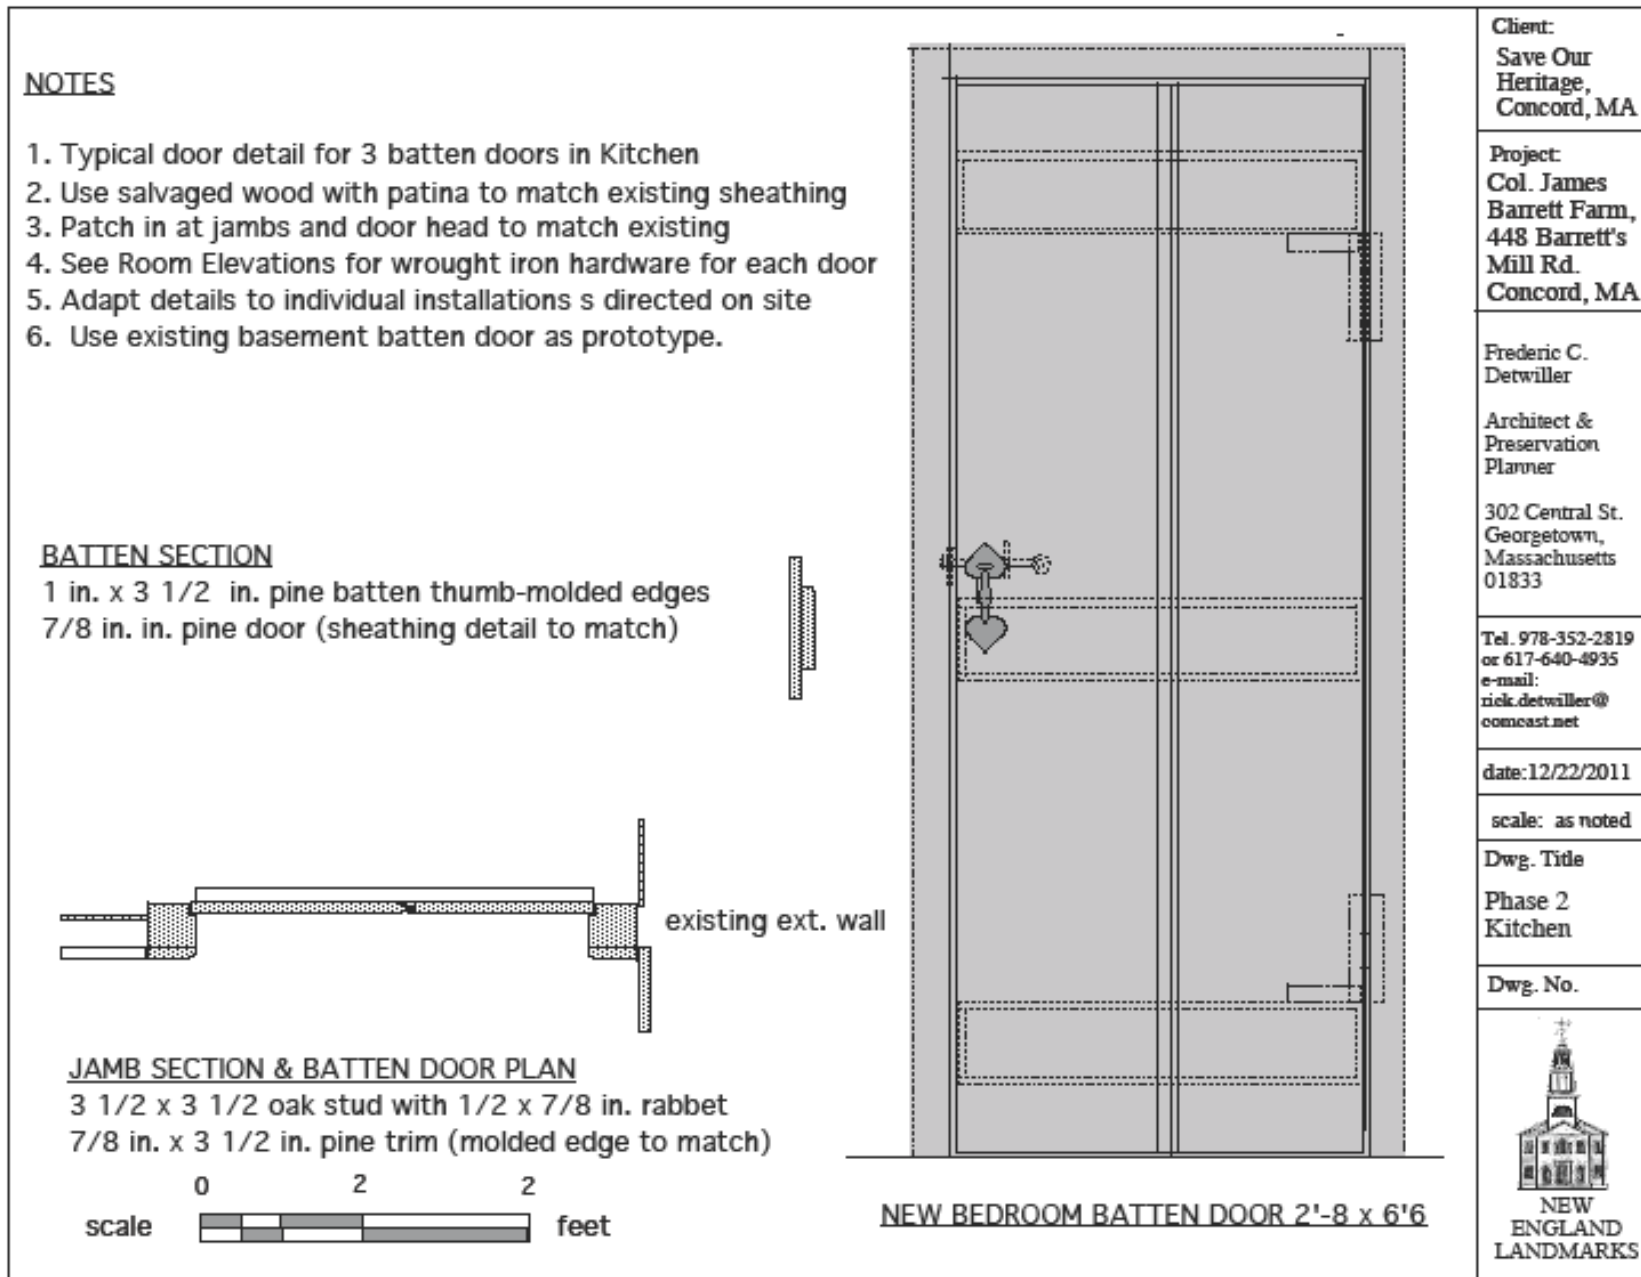


Figure 12 Drawing A12 – Kitchen/Bedroom Door

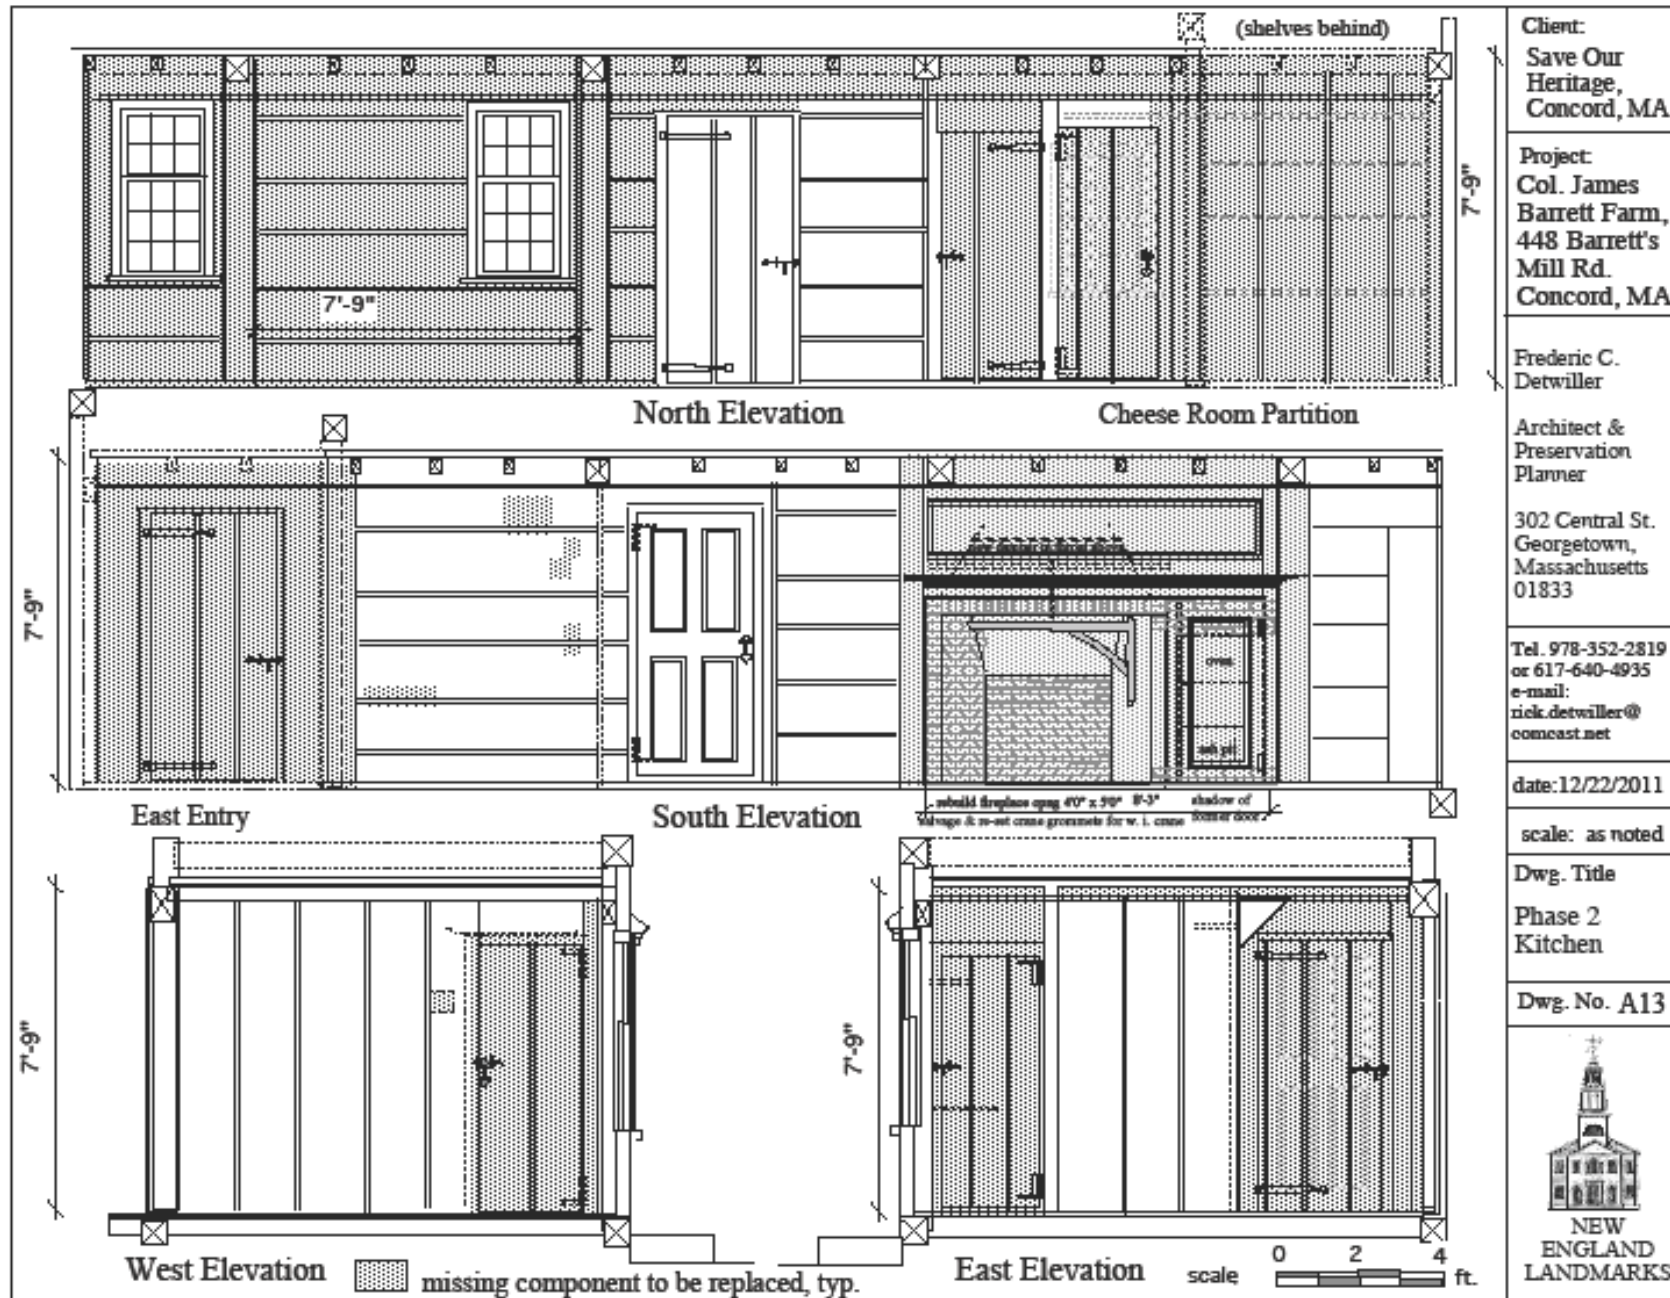


Figure 13 Drawing A13 – Kitchen Elevations



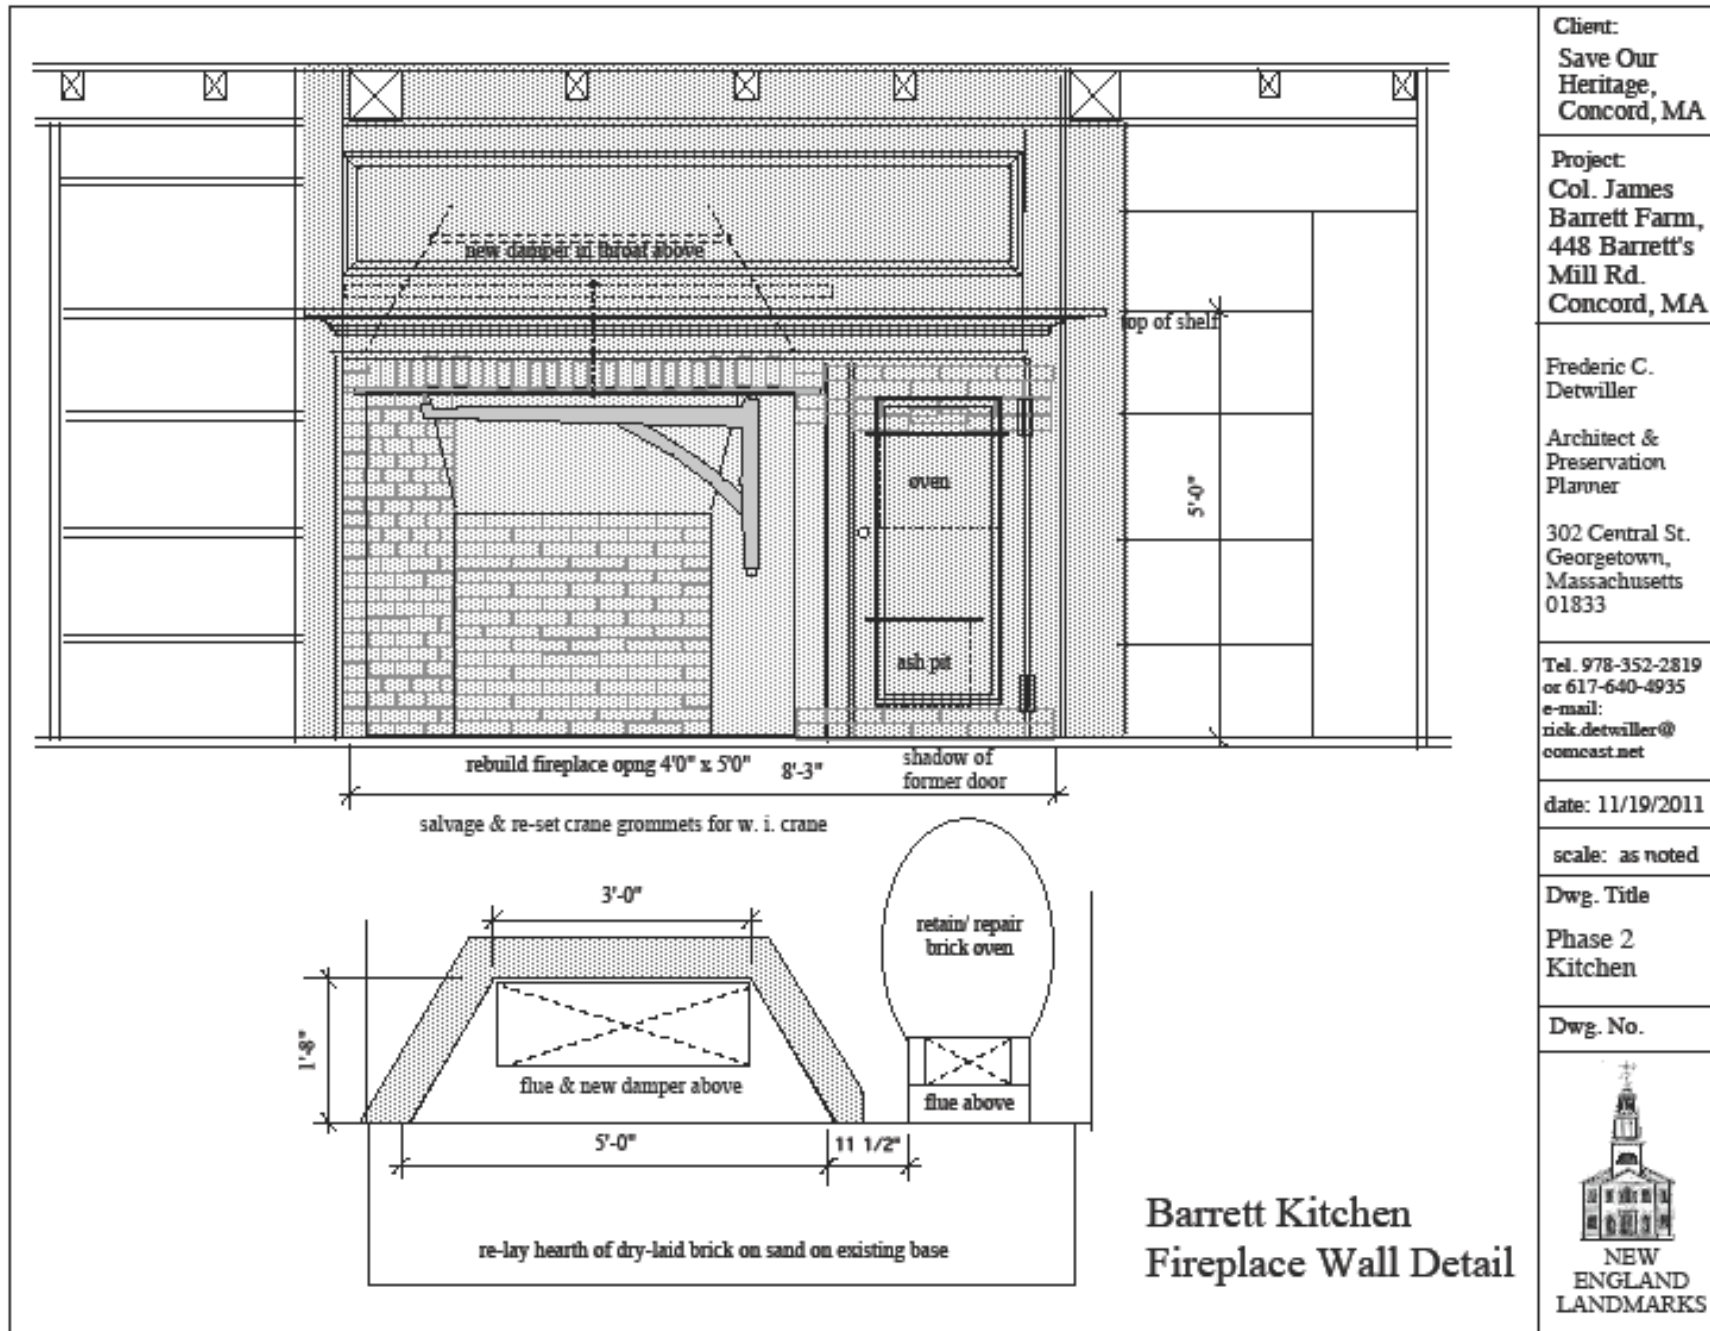


Figure 14 Drawing A14 – Kitchen Fireplace Details

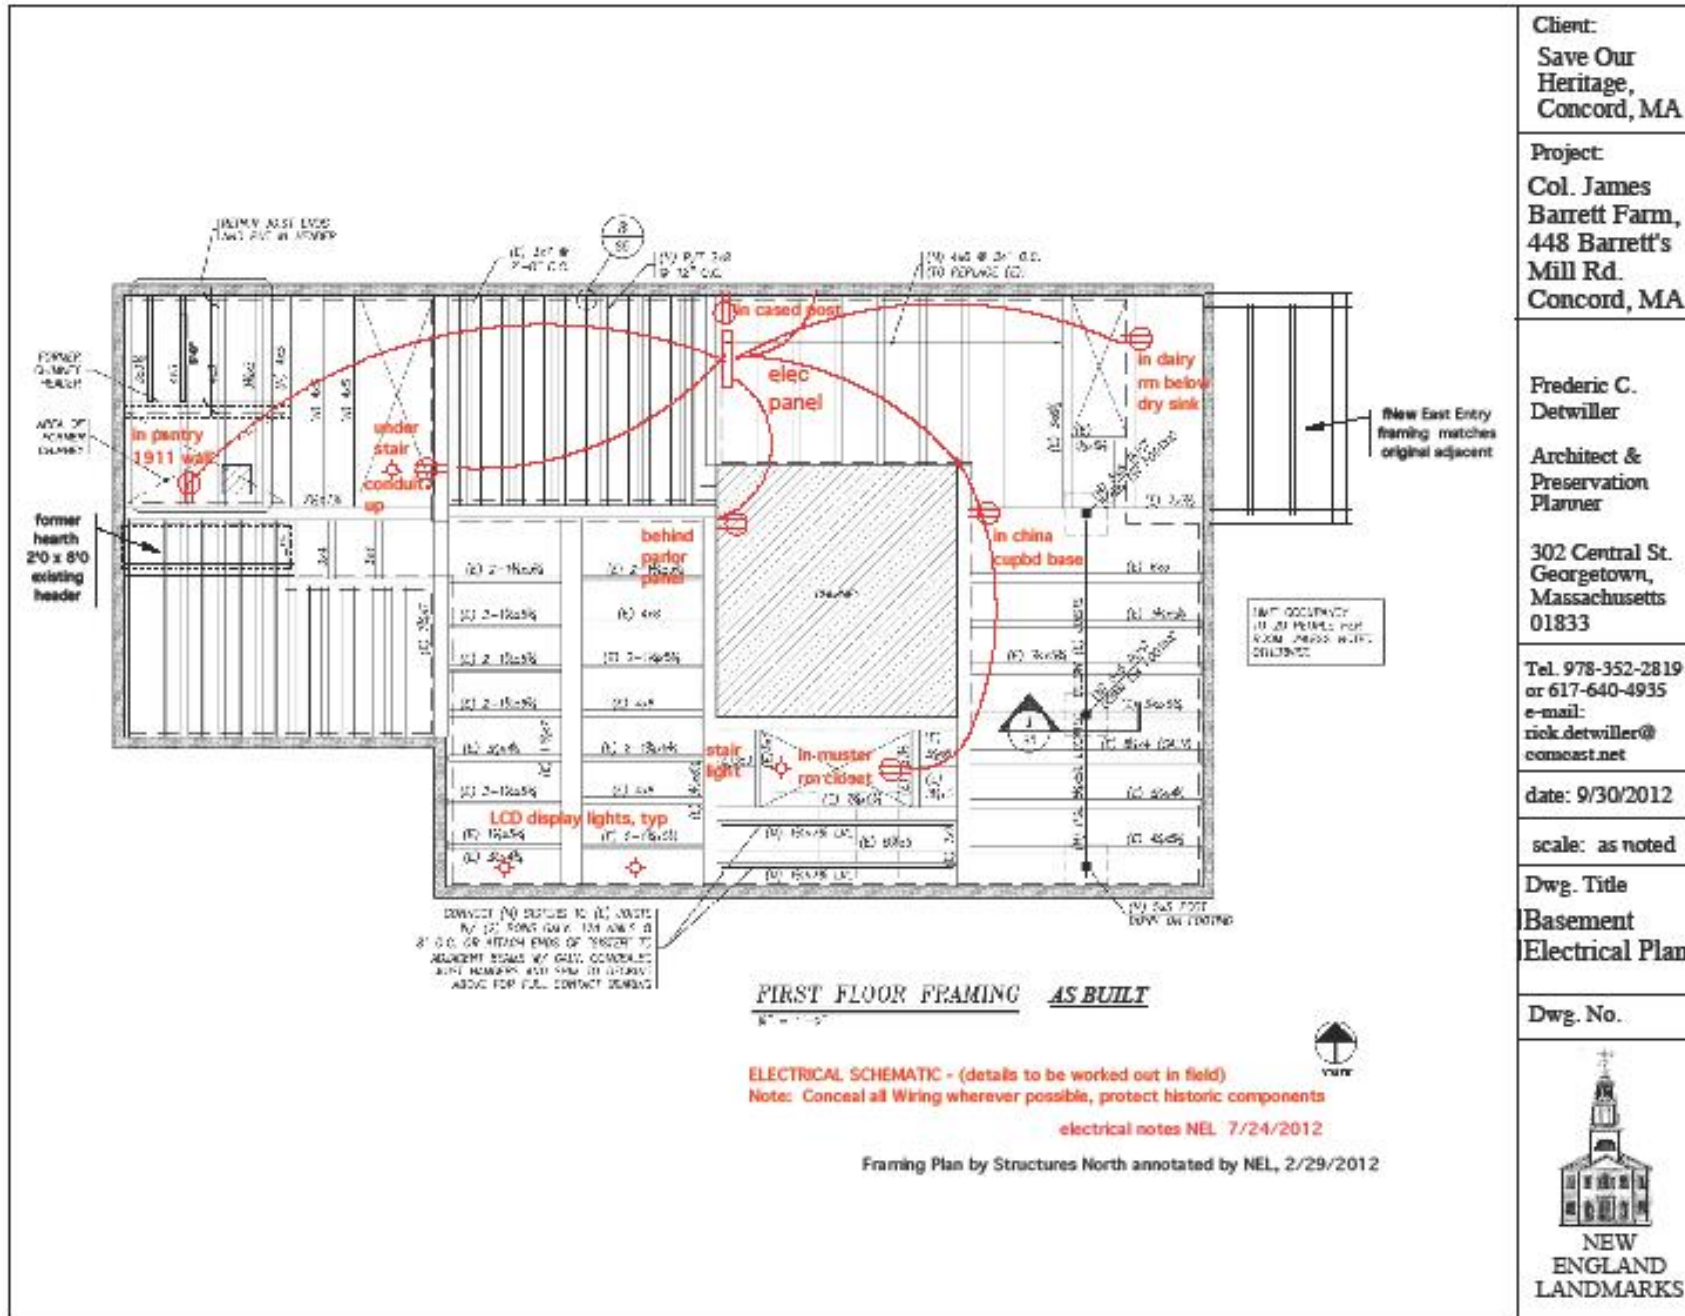


Figure 15 Drawing E1 - Basement Electrical Plan

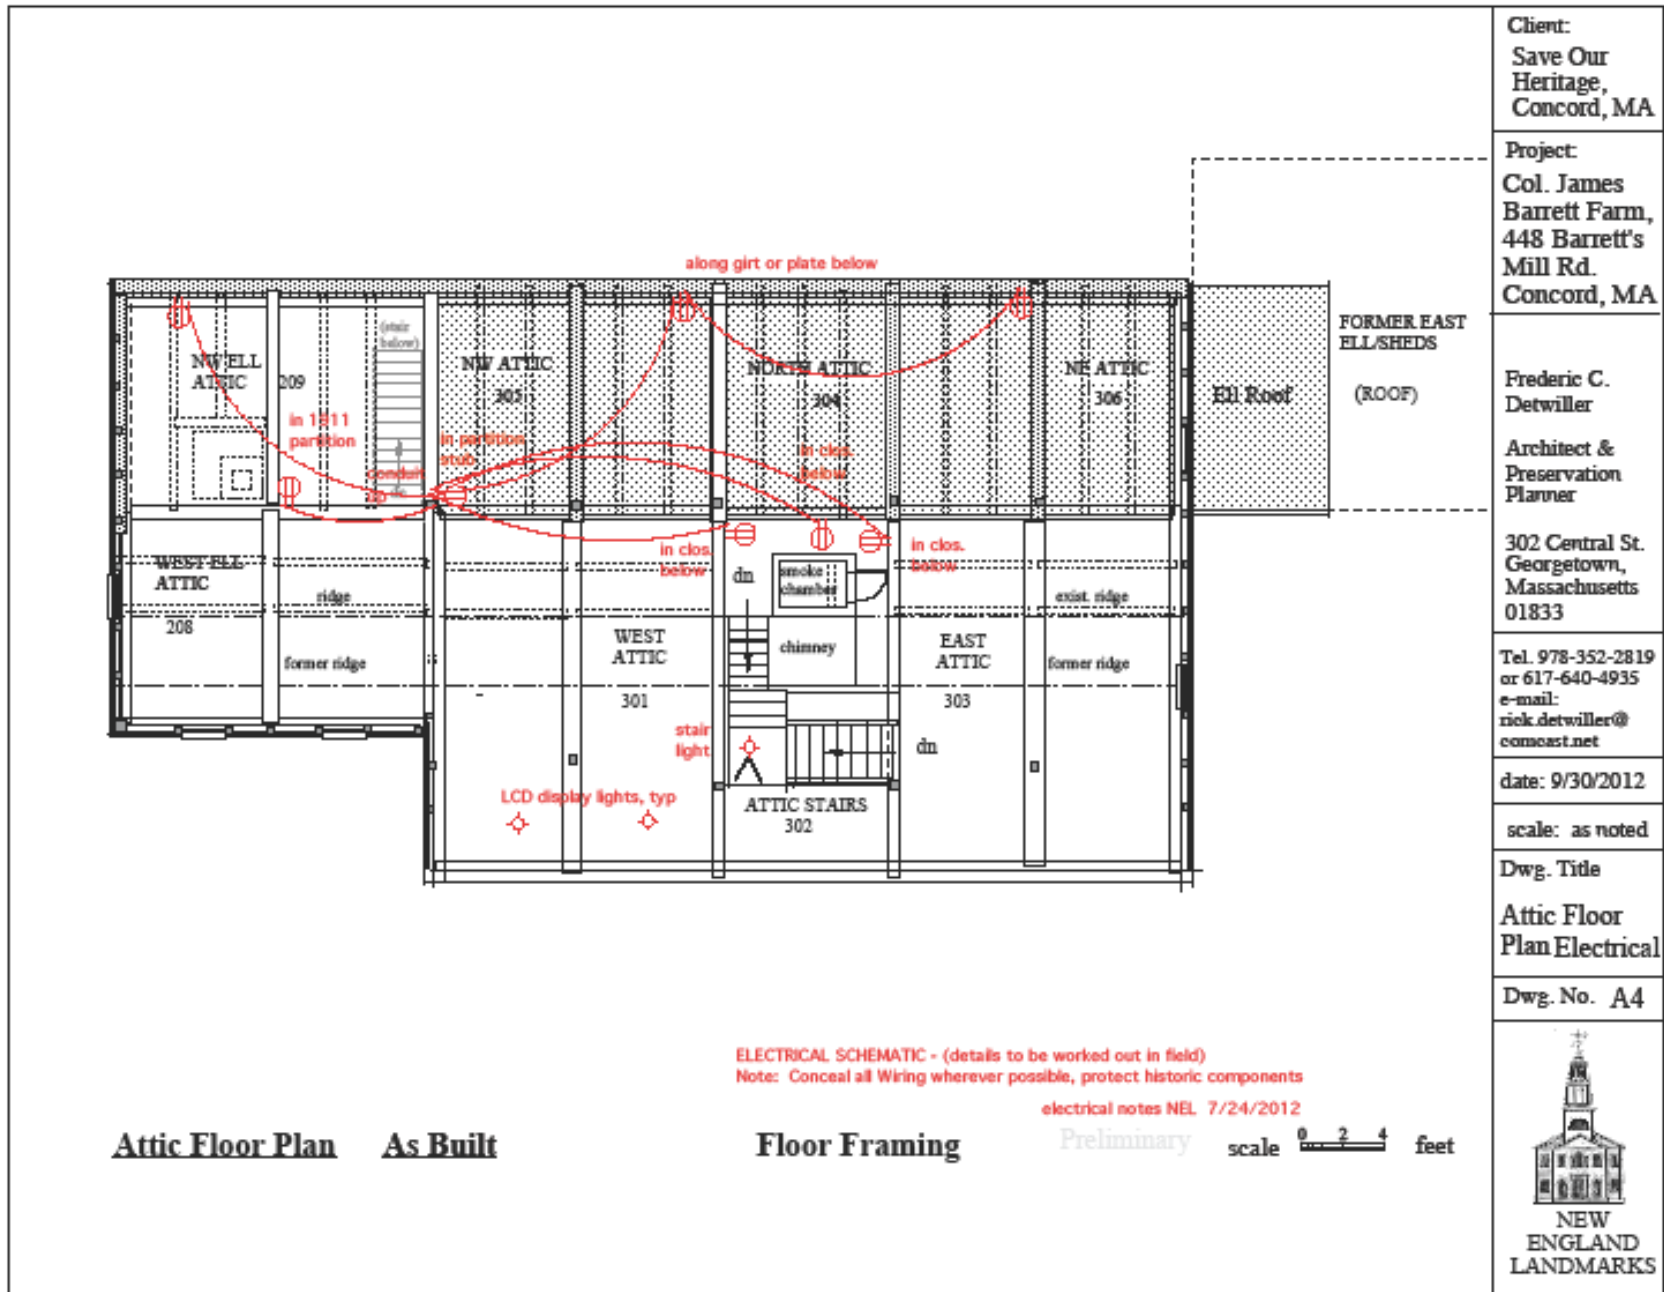


Figure 16 Drawing E2 - Attic Electrical Plan

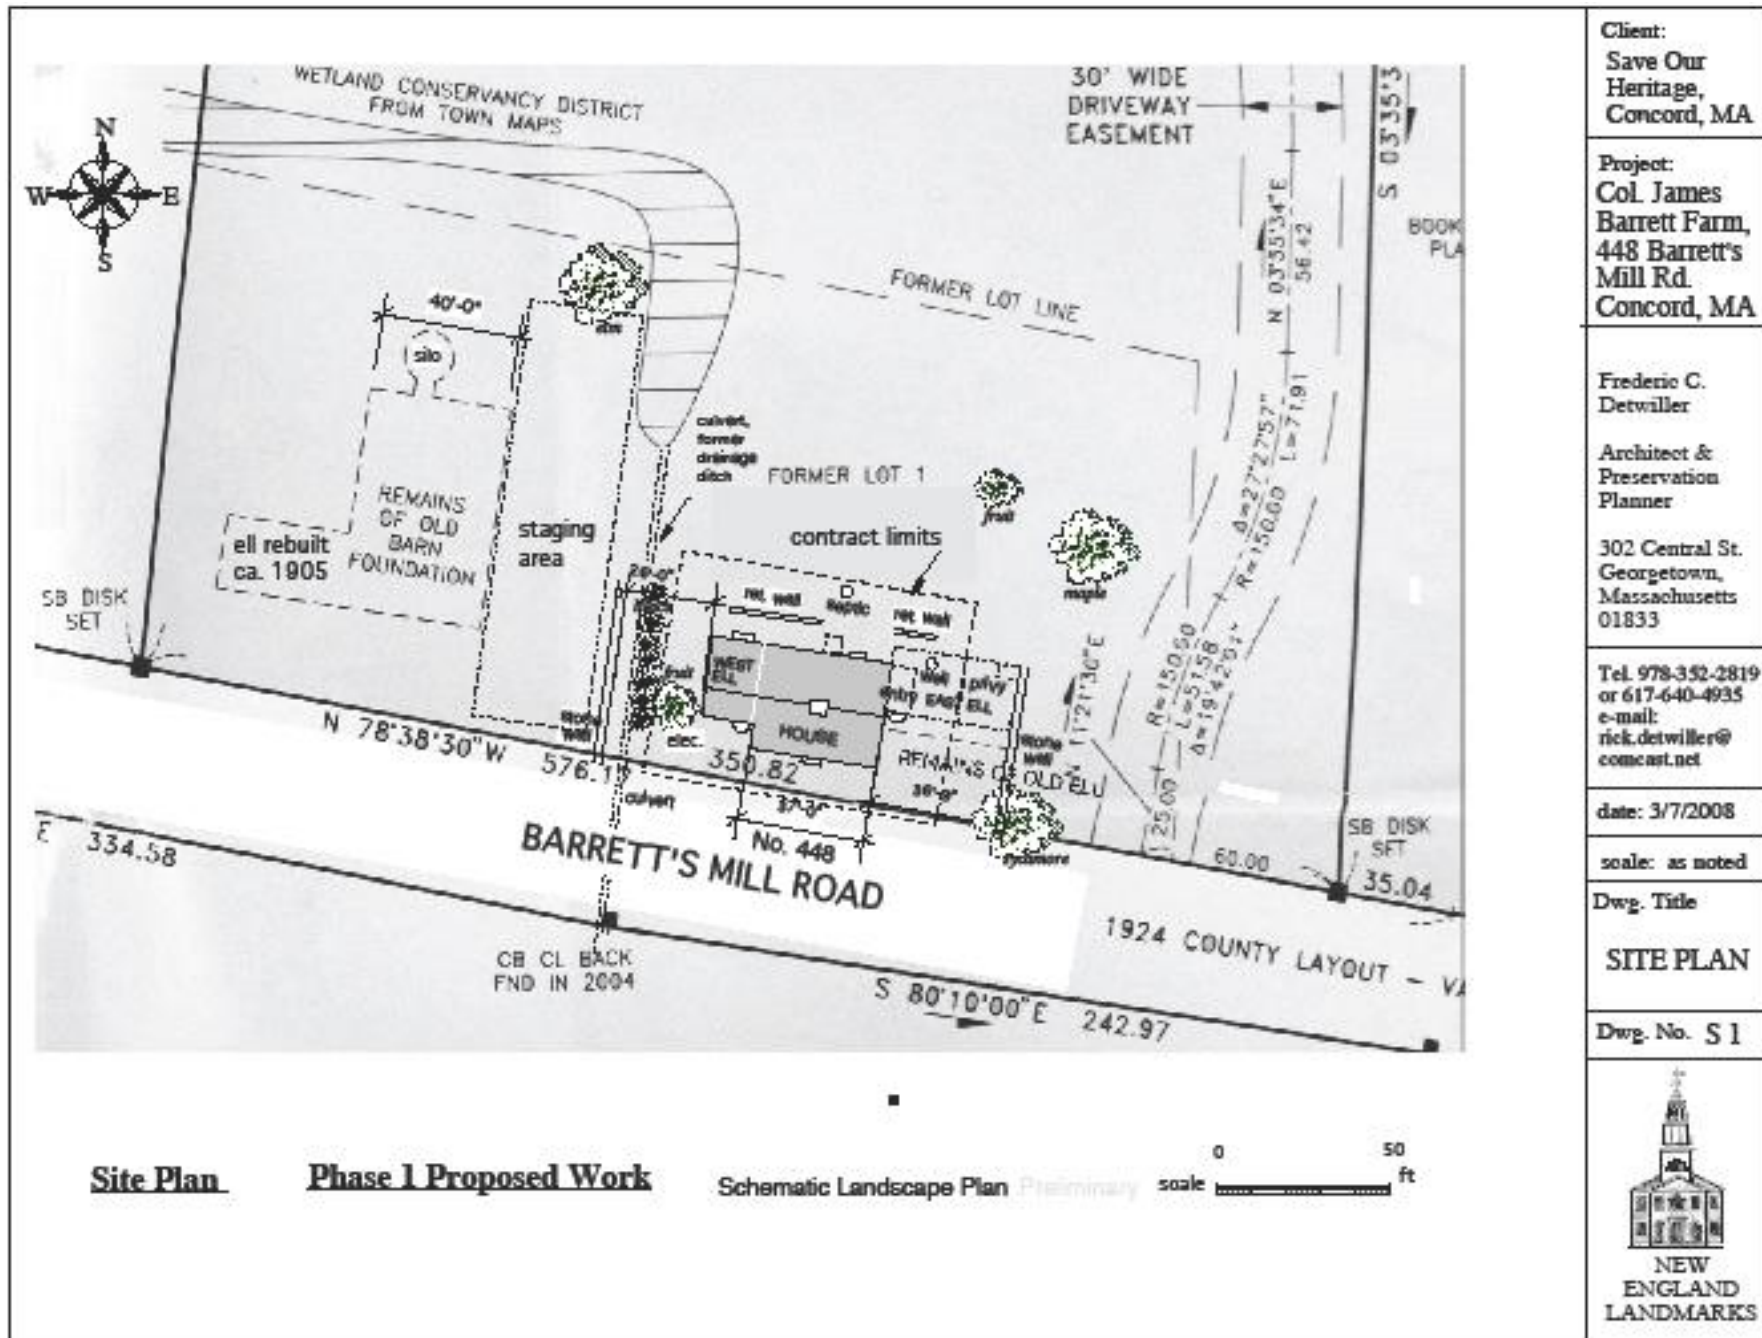


Figure 17 Drawing S1 - Site

<p><b>A. GENERAL</b></p> <ol style="list-style-type: none"> <li>ALL WORK SHALL COMPLY WITH THE FOLLOWING:                  MASSACHUSETTS STATE BUILDING CODE.                  AWS STRUCTURAL WELDING CODE.                  AISC SPECIFICATION FOR THE DESIGN, FABRICATION, ERECTION OF STRUCTURAL STEEL FOR BUILDINGS.</li> <li>ALL STRUCTURAL WORK SHALL BE COORDINATED BETWEEN ALL RELATED TRADES. STRUCTURAL DRAWINGS SHALL BE USED IN CONJUNCTION WITH EXISTING CONDITIONS AND DIMENSIONS DATA TO BE COLLECTED AND VERIFIED BY THE CONTRACTOR.</li> <li>CONTRACTOR SHALL FIELD VERIFY ALL EXISTING CONDITIONS AND DIMENSIONS AND SHALL BE RESPONSIBLE FOR DIMENSIONAL COORDINATION. NOTIFY THE ENGINEER OF ANY AND ALL DISCREPANCIES.</li> <li>SUBMIT SHOP DRAWINGS FOR STRUCTURAL STEEL, MISCELLANEOUS STRUCTURAL PRODUCTS AND FABRICATIONS. WORK SHALL BE DONE FROM APPROVED SUBMITTALS ONLY.</li> <li>ALL DETAILS SHALL BE CONSIDERED TYPICAL AND APPLICABLE TO ALL SIMILAR CONDITIONS UNLESS OTHERWISE NOTED OR INDICATED.</li> <li>THE CONTRACTOR SHALL BE RESPONSIBLE FOR ALL TEMPORARY SHORING AND CURING OF THE EXISTING AND NEW STRUCTURE DURING THE WORK, AND FOR TEMPORARY PROTECTION OF THE SURROUNDING ENVIRONS.</li> <li>THE CONTRACTOR SHALL COORDINATE INSPECTIONS OF STRUCTURE TO MEET THE REQUIREMENTS OF THE MASSACHUSETTS STATE BUILDING CODE AND REFERENCED STANDARDS. THE CONTRACTOR SHALL NOT PROCEED WITH ANY WORK THAT OTHERWISE CONCEALS ITEMS SCHEDULED FOR INSPECTION UNTIL INSPECTION HAS BEEN COMPLETED.</li> <li>THE CONTRACTOR SHALL BE SOLELY RESPONSIBLE FOR ALL MEANS AND METHODS OF CONSTRUCTION EMPLOYED ON THIS PROJECT AND FOR ALL TEMPORARY BRACING, SUPPORT, AND PROTECTION OF THE EXISTING STRUCTURE. CONTRACTOR SHALL BE PREPARED TO RETAIN THE SERVICES OF A MASSACHUSETTS REGISTERED PROFESSIONAL STRUCTURAL ENGINEER AT HIS OWN EXPENSE IF NECESSARY TO MAINTAIN SAFE, STABLE CONDITIONS ON THE PROJECT. ANY SEQUENCES OF WORK OR METHODS INDICATED OR IMPLIED IN THE CONTRACT DOCUMENTS ARE PRESENT ONLY AS ASSUMPTIONS ON WHICH THE DESIGN OF THE PERMANENT INSTALLATIONS ARE BASED AND TO BE CONSIDERED AS SUGGESTED OPTIONS FOR REVIEW BY THE CONTRACTOR.</li> <li>FOLLOWING REVIEW OF EXISTING CONDITIONS AND THE SCOPE OF WORK, THE CONTRACTOR SHALL SUBMIT A WORK SCHEDULE AND KEEP THE ENGINEER AWARE OF ALL PROGRESS AND THE BEGINNING AND COMPLETION OF EACH PHASE OR ITEM OF WORK.</li> <li>CONTRACTOR SHALL BE SOLELY RESPONSIBLE FOR MAINTAINING THE SAFETY AND STABILITY OF THE STRUCTURE, ITS OCCUPANTS, AND ALL ADJACENT STRUCTURES DURING ALL PHASES OF THE WORK, AND SHALL CORRECT ANY DEFECTS OR DAMAGE WHICH RESULTS FROM HIS ACTIONS.</li> </ol> <p><b>B. DESIGN LOADS</b></p> <ol style="list-style-type: none"> <li>THE FOLLOWING LOADS ARE CONSIDERED:                  ROOF SNOW LOAD: 35 PSF</li> <li>OCCUPANCIES OF BUILDING SHALL BE LIMITED DUE TO REDUCED ALLOWABLE CAPACITY OF EXISTING STRUCTURAL MEMBERS. OCCUPANCIES ARE NOTED ON STRUCTURAL PLANS. PER MASSACHUSETTS STATE BUILDING CODE, AREA WITH LIMITED CAPACITIES SHALL BE CLEARLY SIGNPOSTED.</li> </ol> <p><b>C. TEMPORARY SHORING AND BRACING:</b></p> <ol style="list-style-type: none"> <li>PROVIDE AND INSTALL TEMPORARY SHORING DESIGNED TO SUPPORT THE TEMPORARY STRUCTURAL LOADS OF THE SUPPORTED ITEMS. SUBMIT SHORING PRODUCTS, CONFIGURATION AND PROCEDURE, TO THE ENGINEER FOR RECORD AND REVIEW.</li> <li>SHORING SHALL BE OF ANY MATERIAL WHICH IS SUITABLE FOR THE APPLICATION. TIMBER SHORING SHALL BE FULLY DRIED AND ALL END GRAIN SHALL BE SEALED TO PREVENT FLUCTUATIONS IN MOISTURE CONTENT. SHORING SHALL BE MADE STABLE, STIFF, AND SNUG FITTING SO AS NOT TO DEFLECT UNDER LOAD. PRE LOAD SUPPORTED ELEMENTS FOR SNUG FIT ONLY. SHORING SHALL ALLOW DEFLECTION OF NO MORE THAN THE GIVEN SPAN LENGTH DIVIDED BY 360 OR APPROPRIATE FOR THE MATERIAL.</li> <li>BEARING SURFACES OF SHORING SHALL BE REVIEWED WITH ENGINEER AND SHALL TO PROVIDE FOR PROPER TRANSFER OF LOADS TO SUPPORTING AND SUPPORTED ELEMENTS.</li> </ol>	<p><b>TYPICAL STUD REPAIR DETAIL</b>          1" = 1'-0"</p> <p><b>TYPICAL POST DUTCHMAN DETAIL</b>          1" = 1'-0"</p>	<p>Client:          Save Our Heritage,          Concord, MA</p>
	<p><b>TYPICAL SILL REPLACEMENT DETAIL</b>          1" = 1'-0" (AS NEEDED)</p> <p>NOTES:          - REPLACEMENT WOOD &amp; SCAB TO BE WHITE OAK #2.          - BORIC ACID—TREAT ALL WOOD.</p> <p>NOTES:          - NEW WOOD TO BE WHITE OAK #2.          - BORIC ACID—TREAT ALL WOOD.</p>	<p>Project:          Col. James Barrett Farm,          448 Barrett's Mill Rd.          Concord, MA</p>
	<p>NOTES:          - SILL MATERIAL TO BE WHITE OAK #2          - CUT JOIST POCKETS OR TRIM AND HANGER—SUPPORT JOISTS ON FAR SIDE          - BORIC ACID—TREAT ALL WOOD</p>	<p>Frederic C. Detwiler          Architect &amp; Preservation Planner          302 Central St.          Georgetown, Massachusetts          01833</p>
		<p>Tel. 978-352-2819          or 617-640-4935          e-mail:          detwiler@rcn.com</p>
		<p>date: 03/07/2008</p>
		<p>scale: As Noted          @ 18x24</p>
		<p>80 Washington St., Suite 401          Salem, MA 01870-3617          TEL: 978-352-2819   FAX: 978-352-2819          www.structures-north.com</p>
		<p>Dwg. Title  <b>GENERAL NOTES &amp; DETAILS</b></p>
		<p>Dwg. No. S0</p>

Figure 18 Structural Drawing S-0 – General Notes


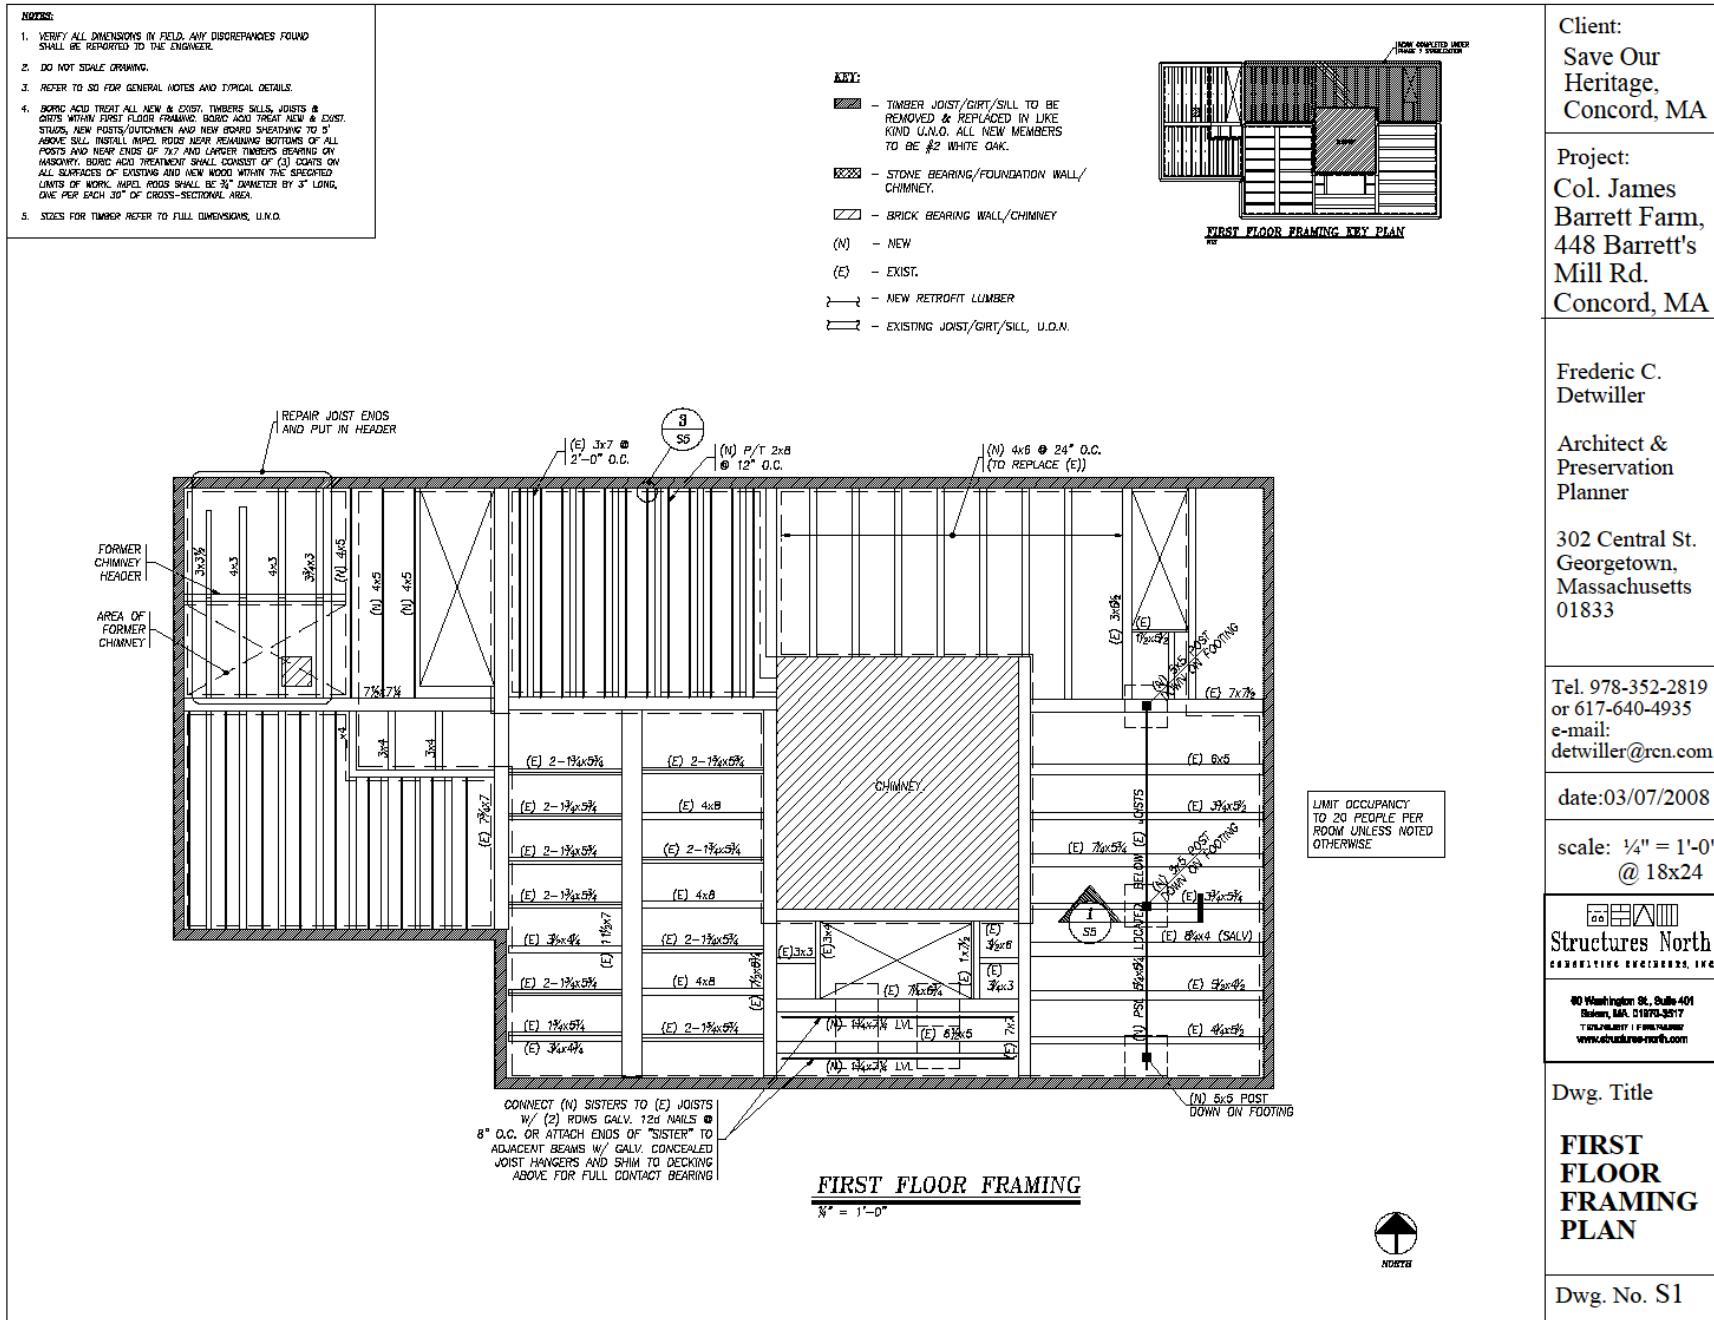


Figure 19 Structural Drawing S-1 – First Floor Framing

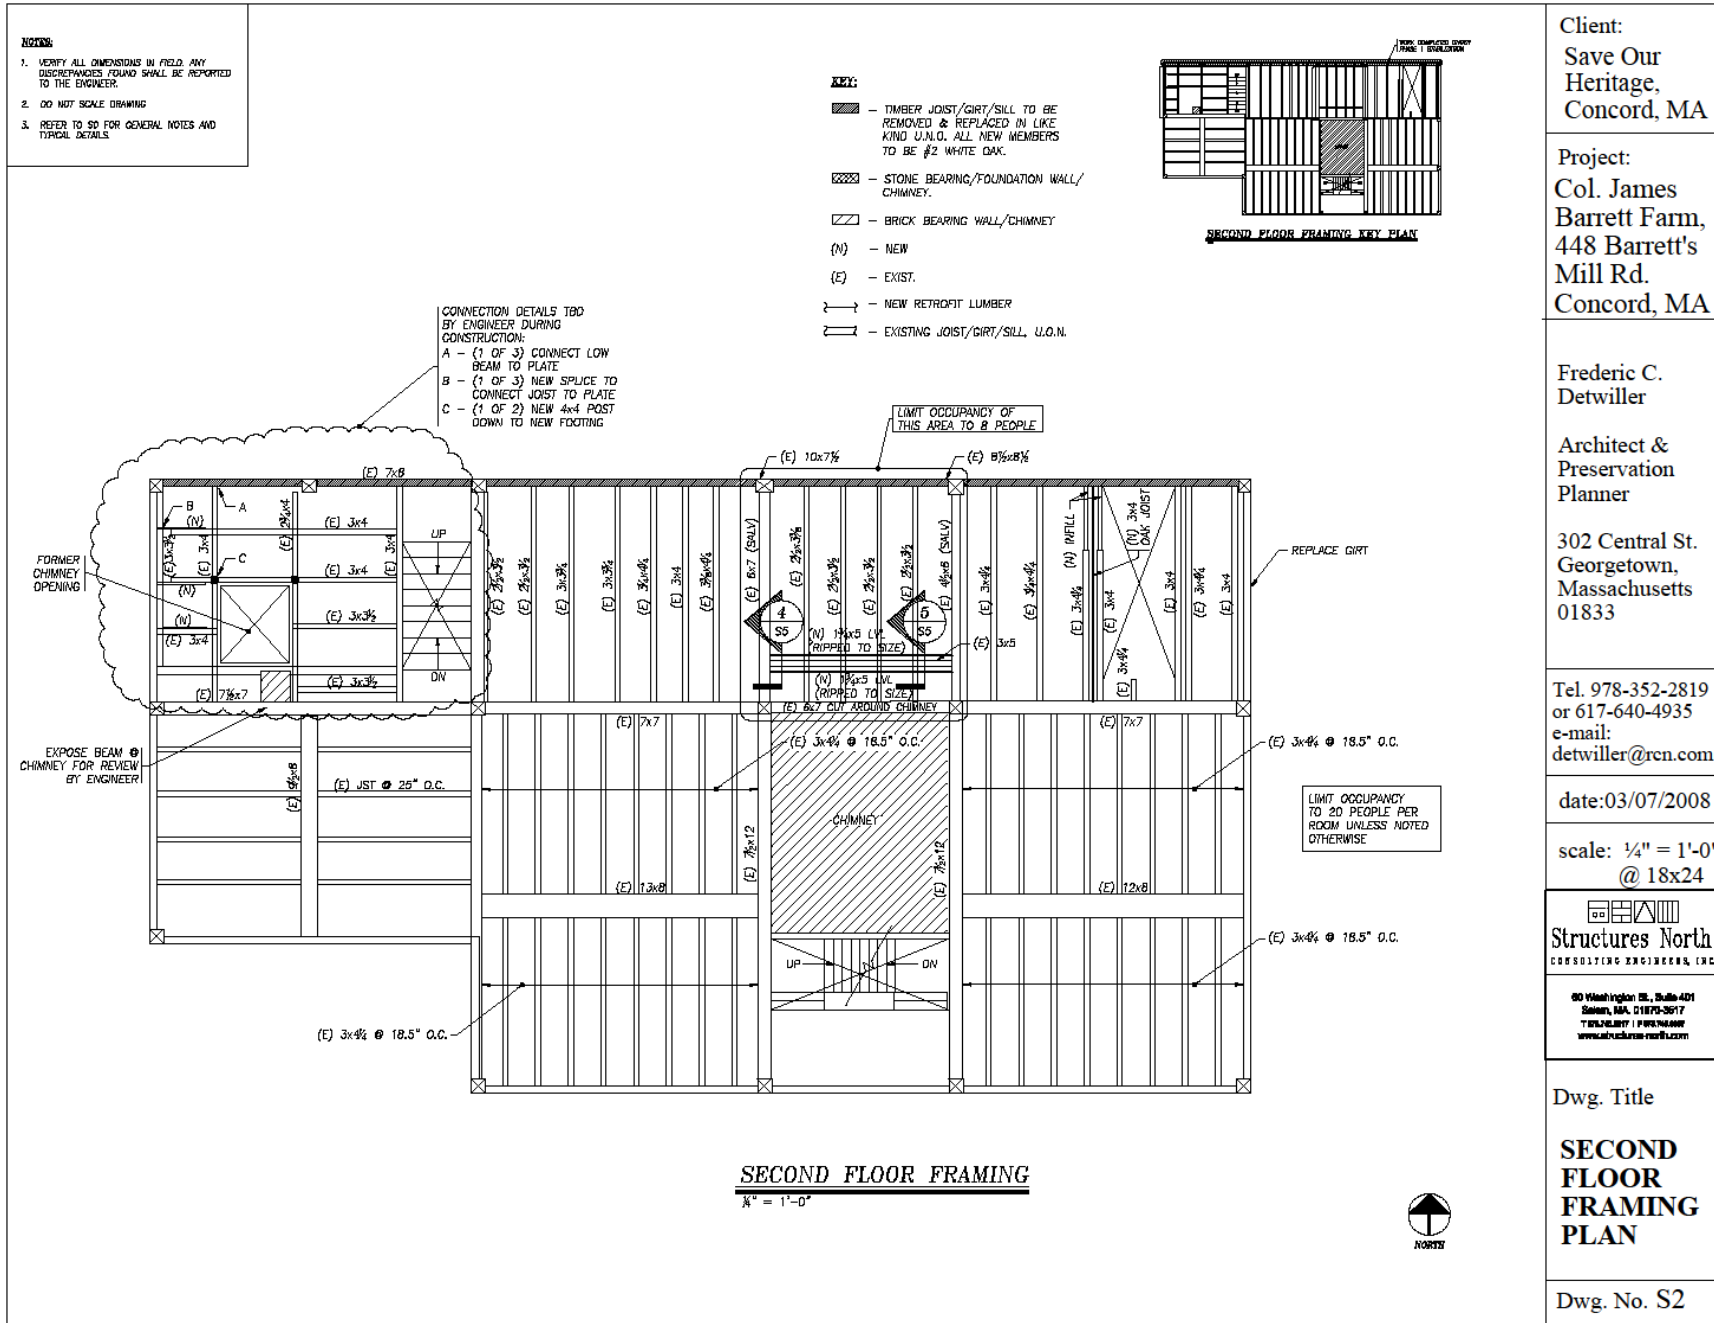

Client:  
Save Our Heritage,  
Concord, MA

Project:  
Col. James Barrett Farm,  
448 Barrett's Mill Rd.  
Concord, MA

Frederic C. Detwiler  
Architect & Preservation Planner

302 Central St.  
Georgetown,  
Massachusetts 01833

Tel. 978-352-2819  
or 617-640-4935  
e-mail:  
detwiler@rcn.com

date:03/07/2008

scale: 1/4" = 1'-0"  
@ 18x24

  
**Structures North**  
CONSULTING ENGINEERS, INC.

80 Wilmington St., Suite 421  
Salem, MA 01875-3617  
TEL: 978.777.1188 FAX: 978.777.1189  
www.structuresnorth.com

Dwg. Title

**SECOND FLOOR FRAMING PLAN**

Dwg. No. S2

Figure 20 Structural Drawing S-2 – Second Floor Framing

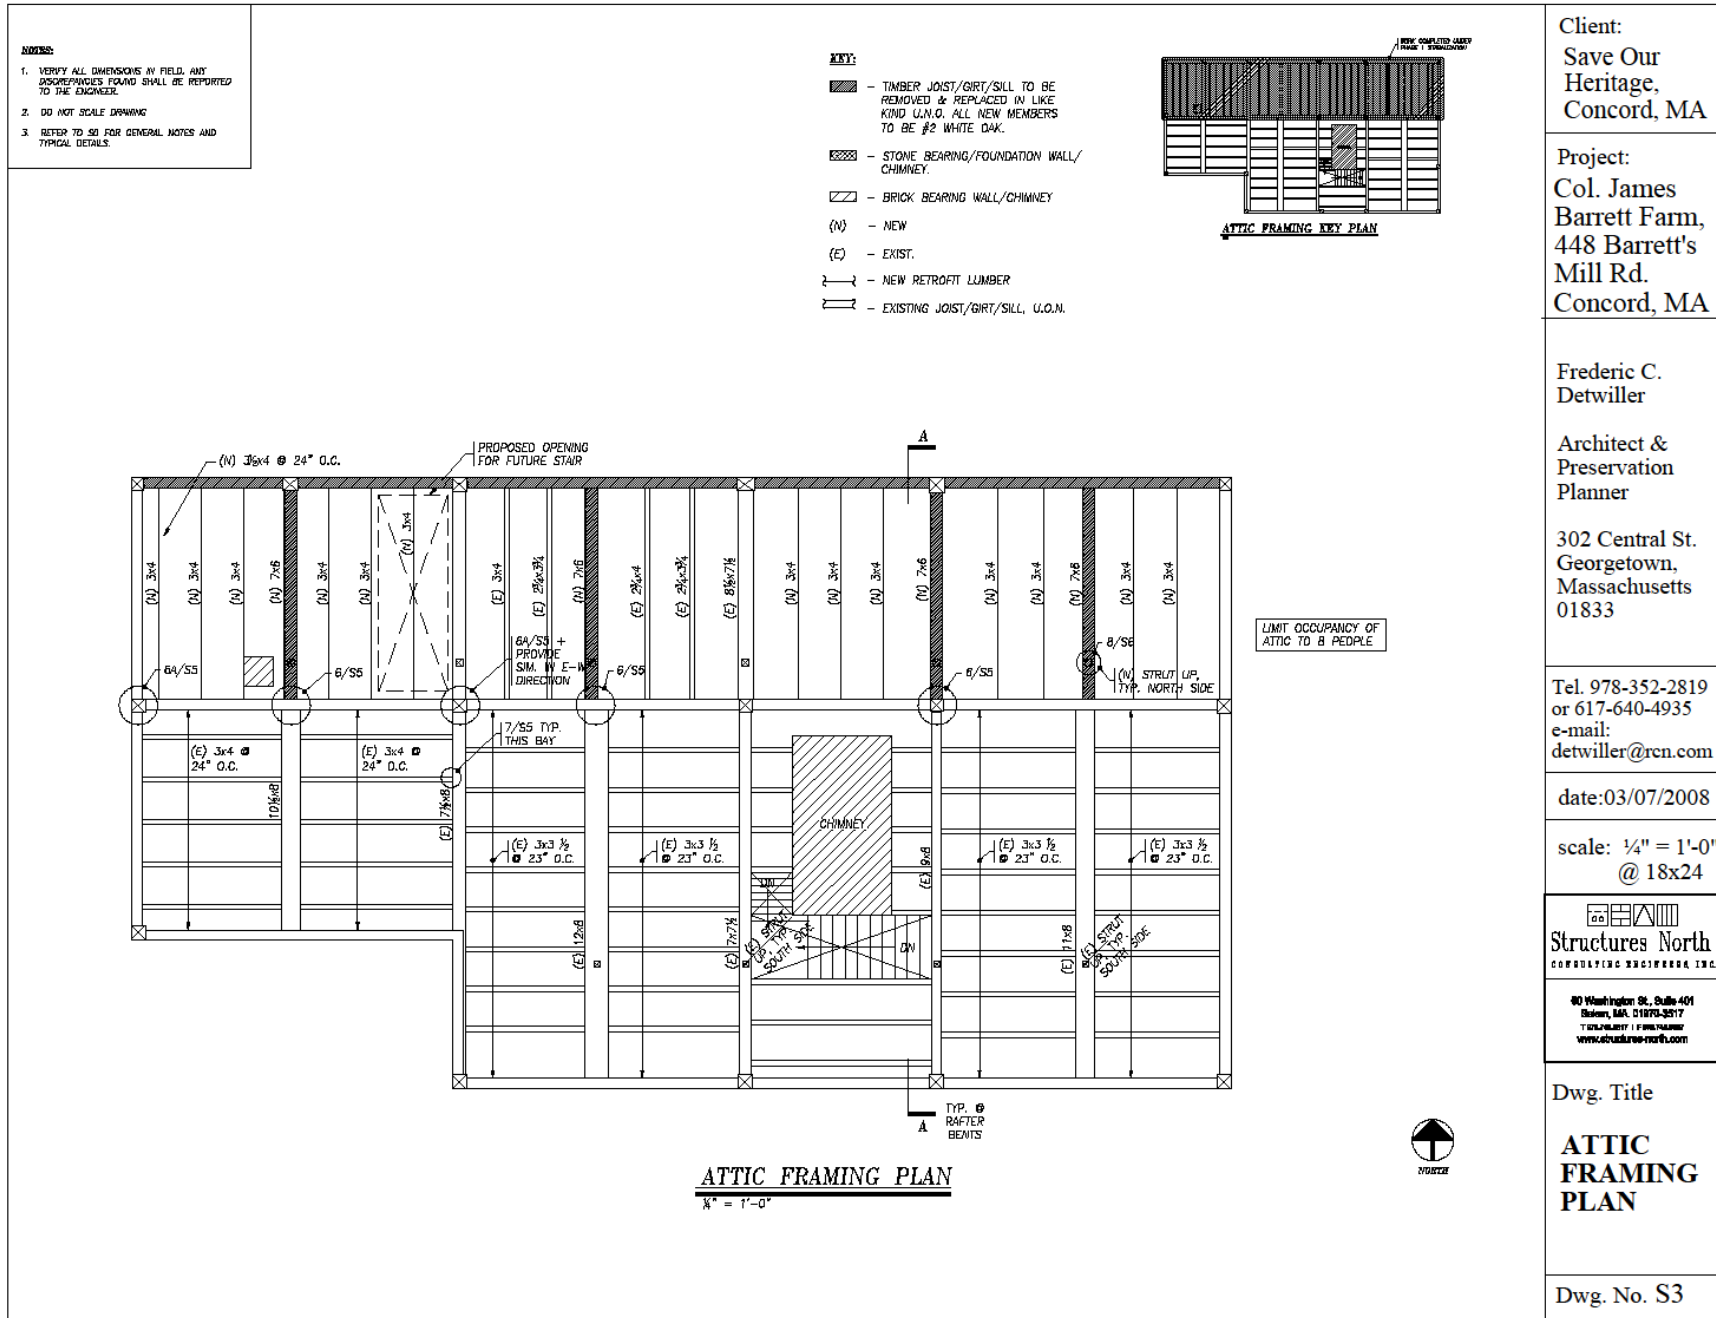


Figure 21 Structural Drawing S-3 – Attic Framing



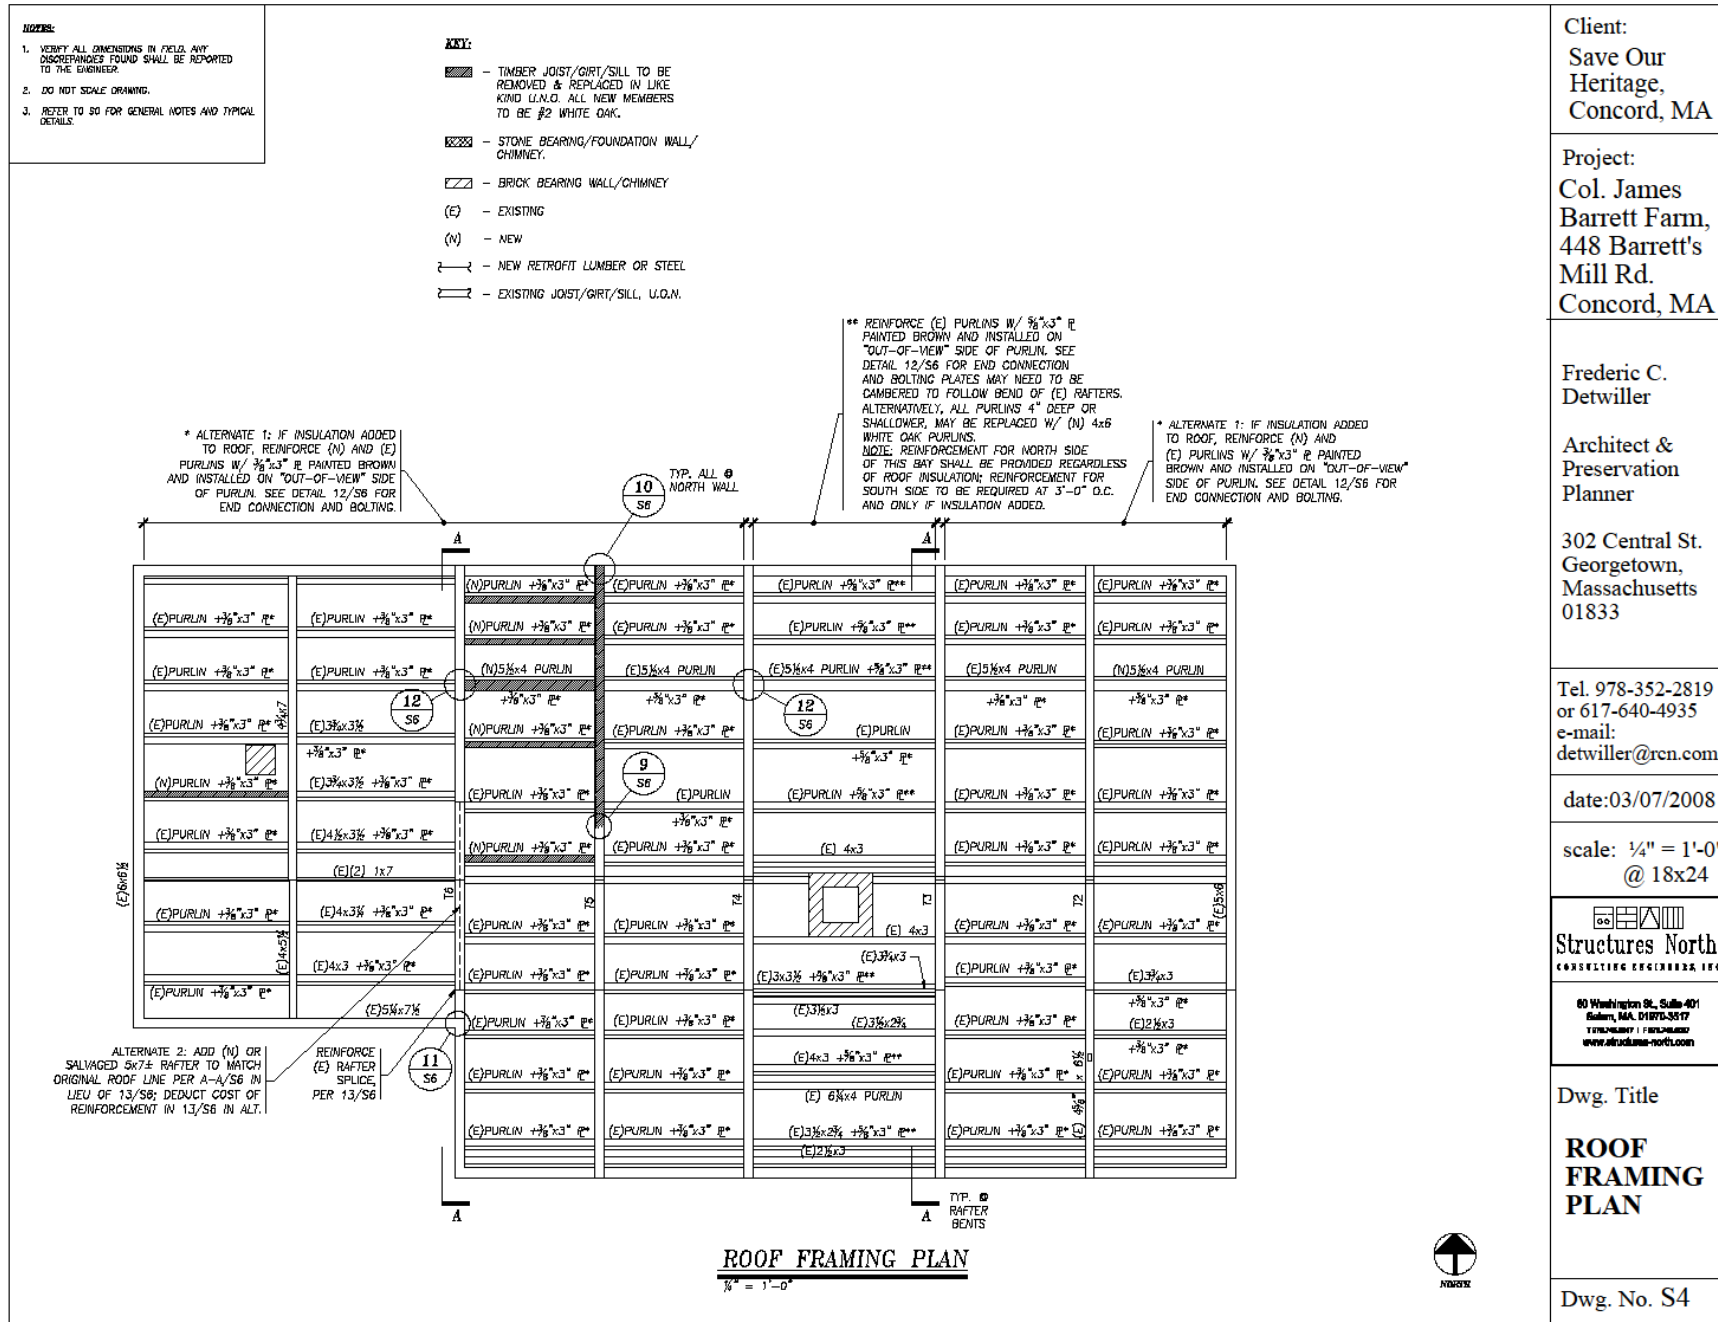


Figure 22 Structural Drawing S-4 – Roof Framing

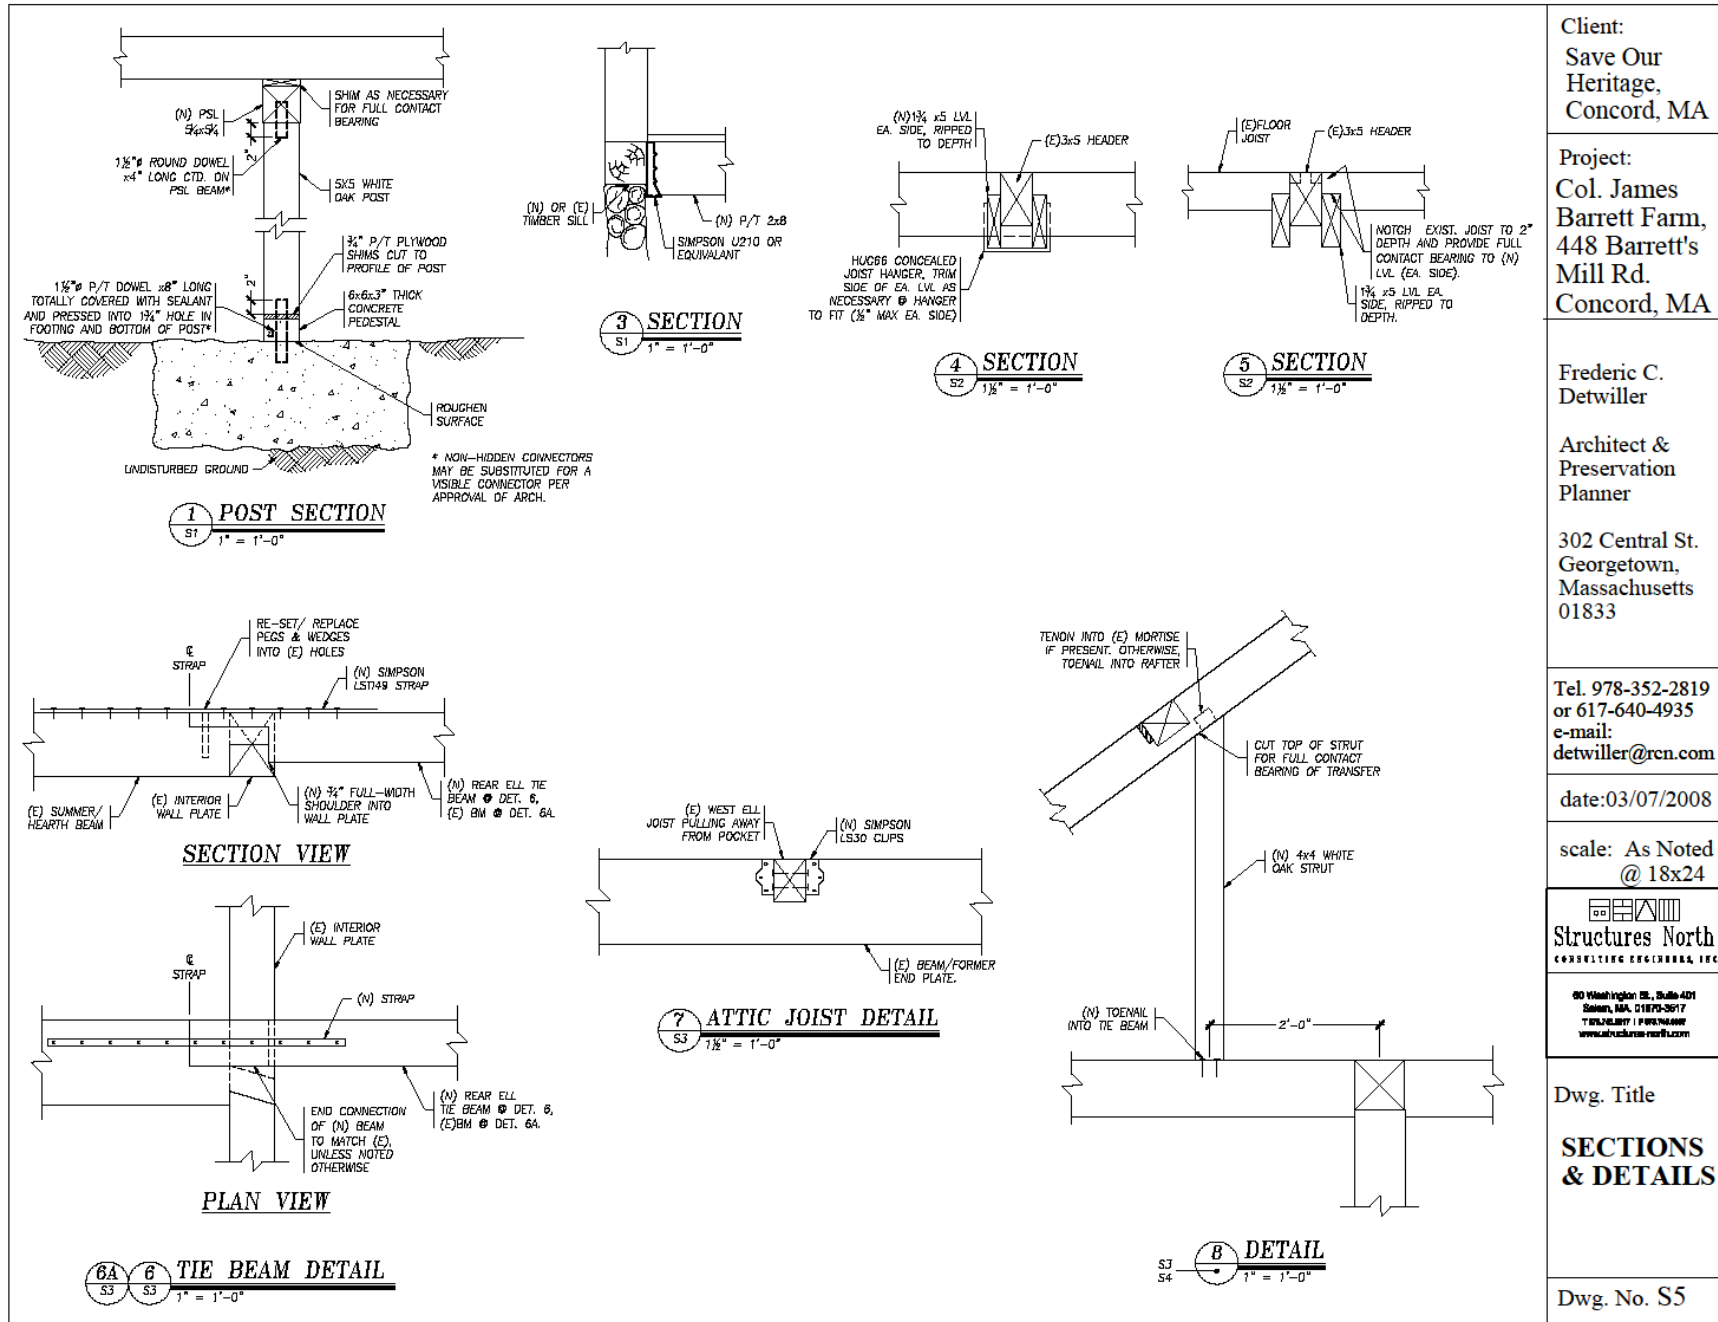


Figure 23 Structural Drawing S-5 – Sections and Details

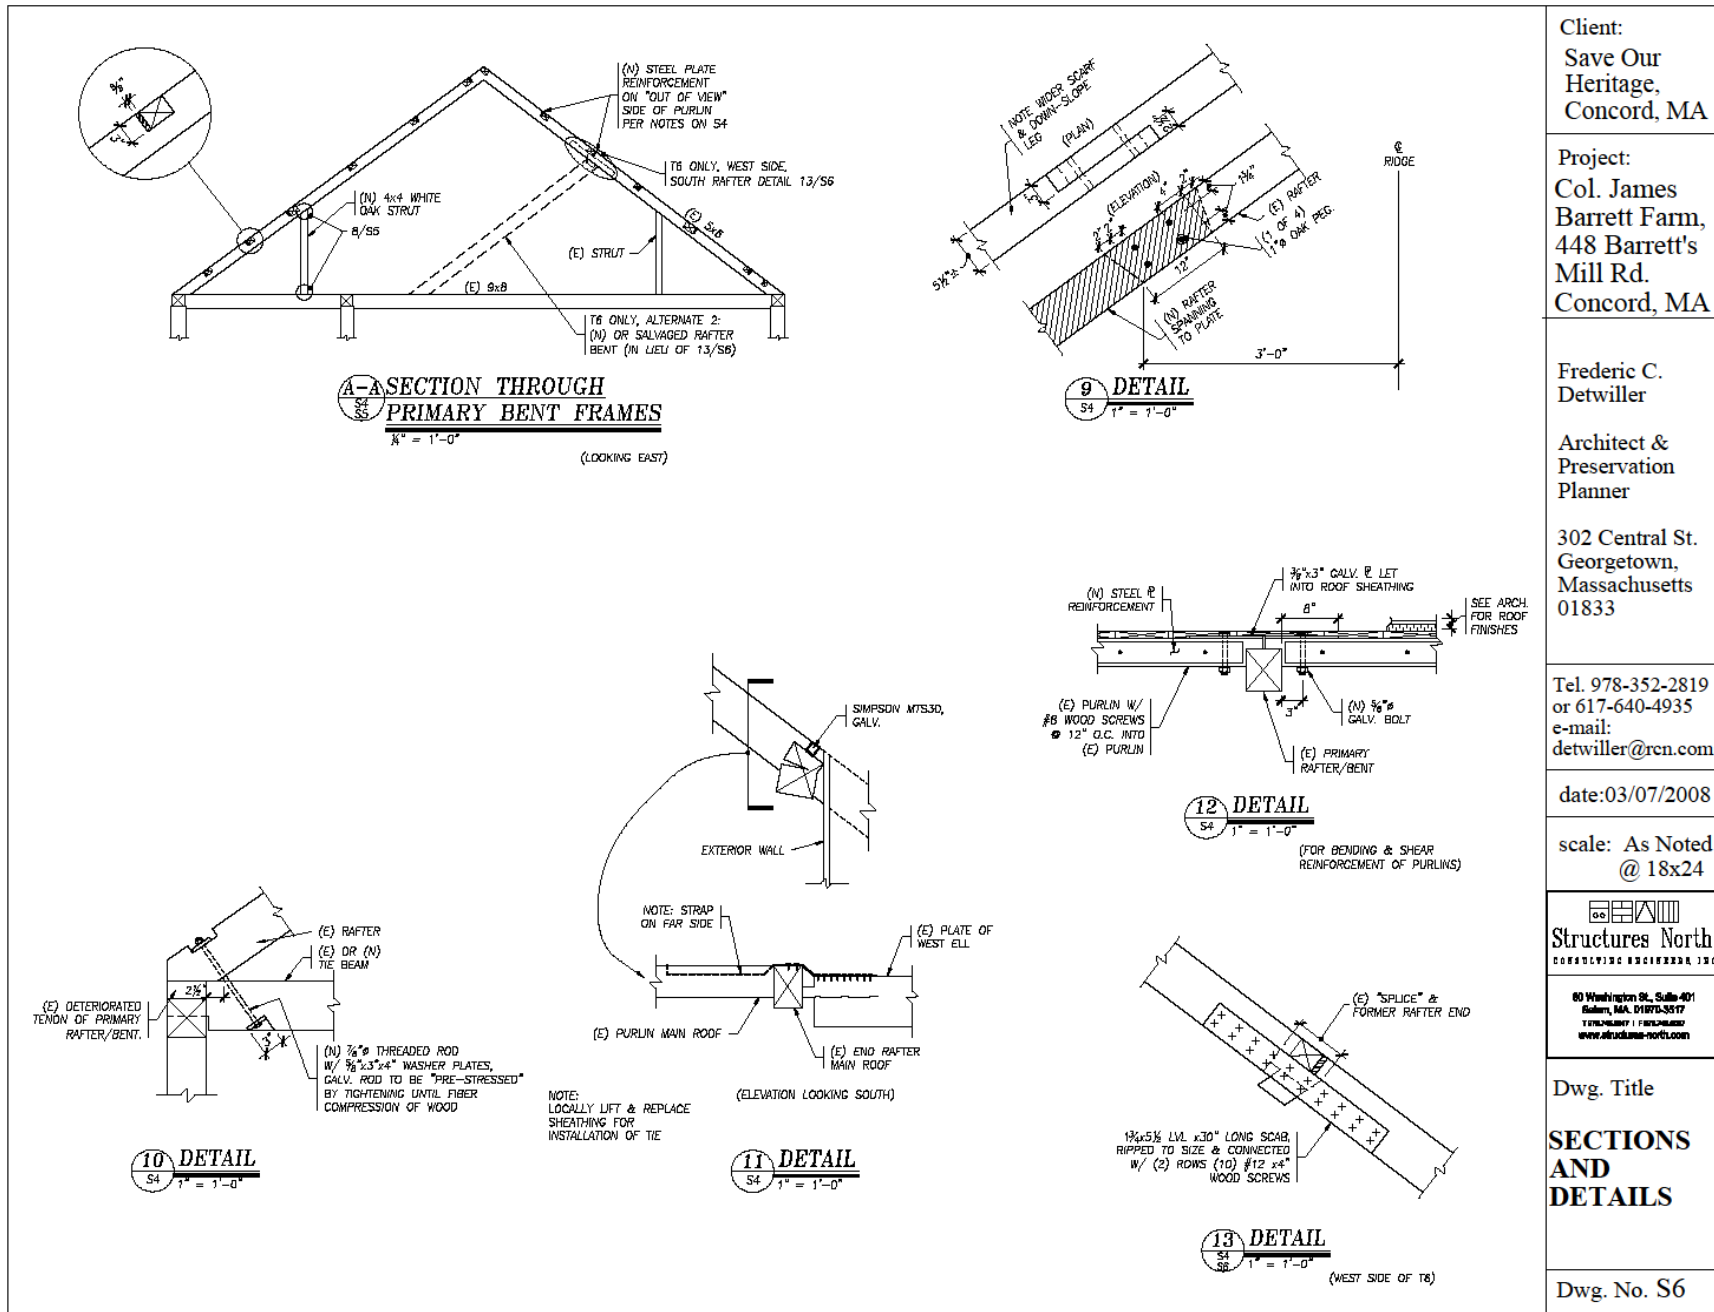


Figure 24 Structural Drawing S-6 – Roof Truss

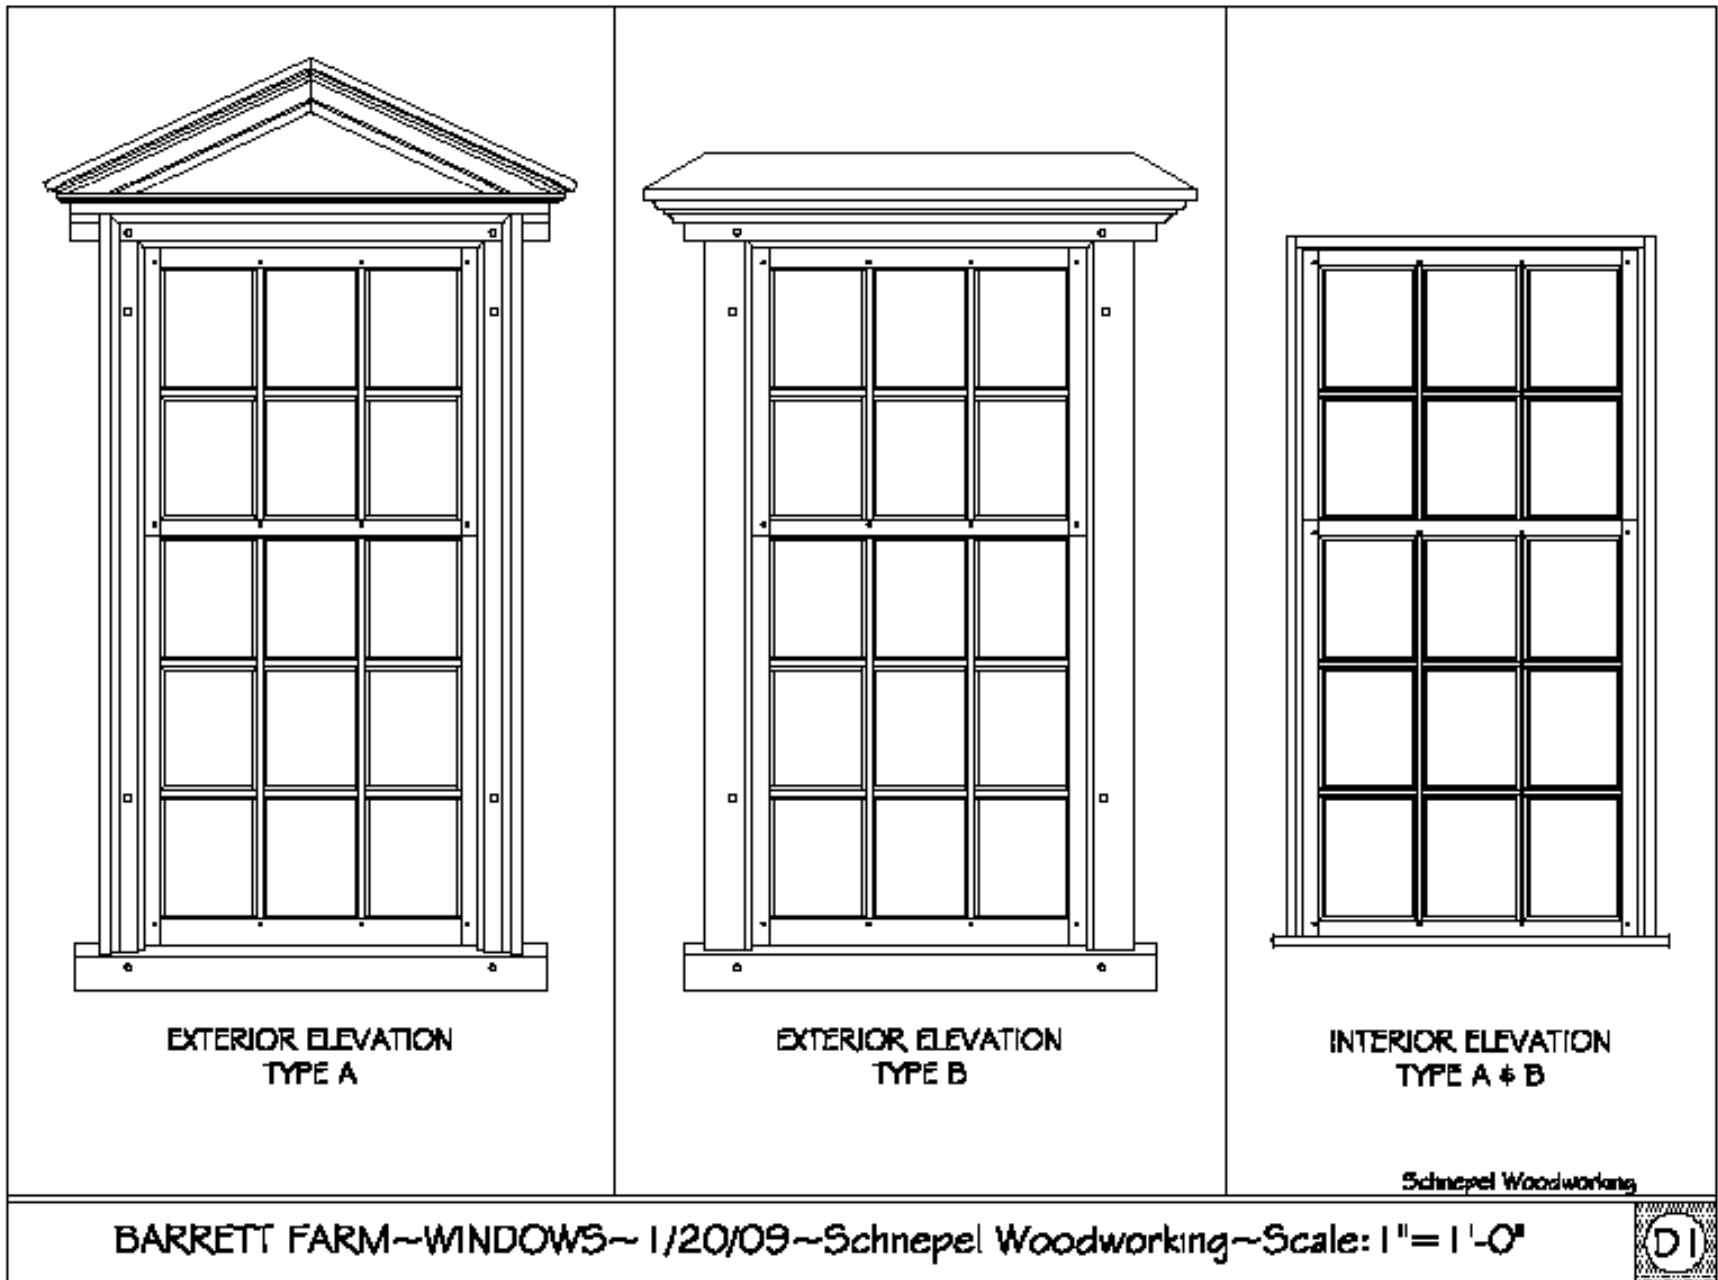


Figure 25 Window Drawing D1 - Types

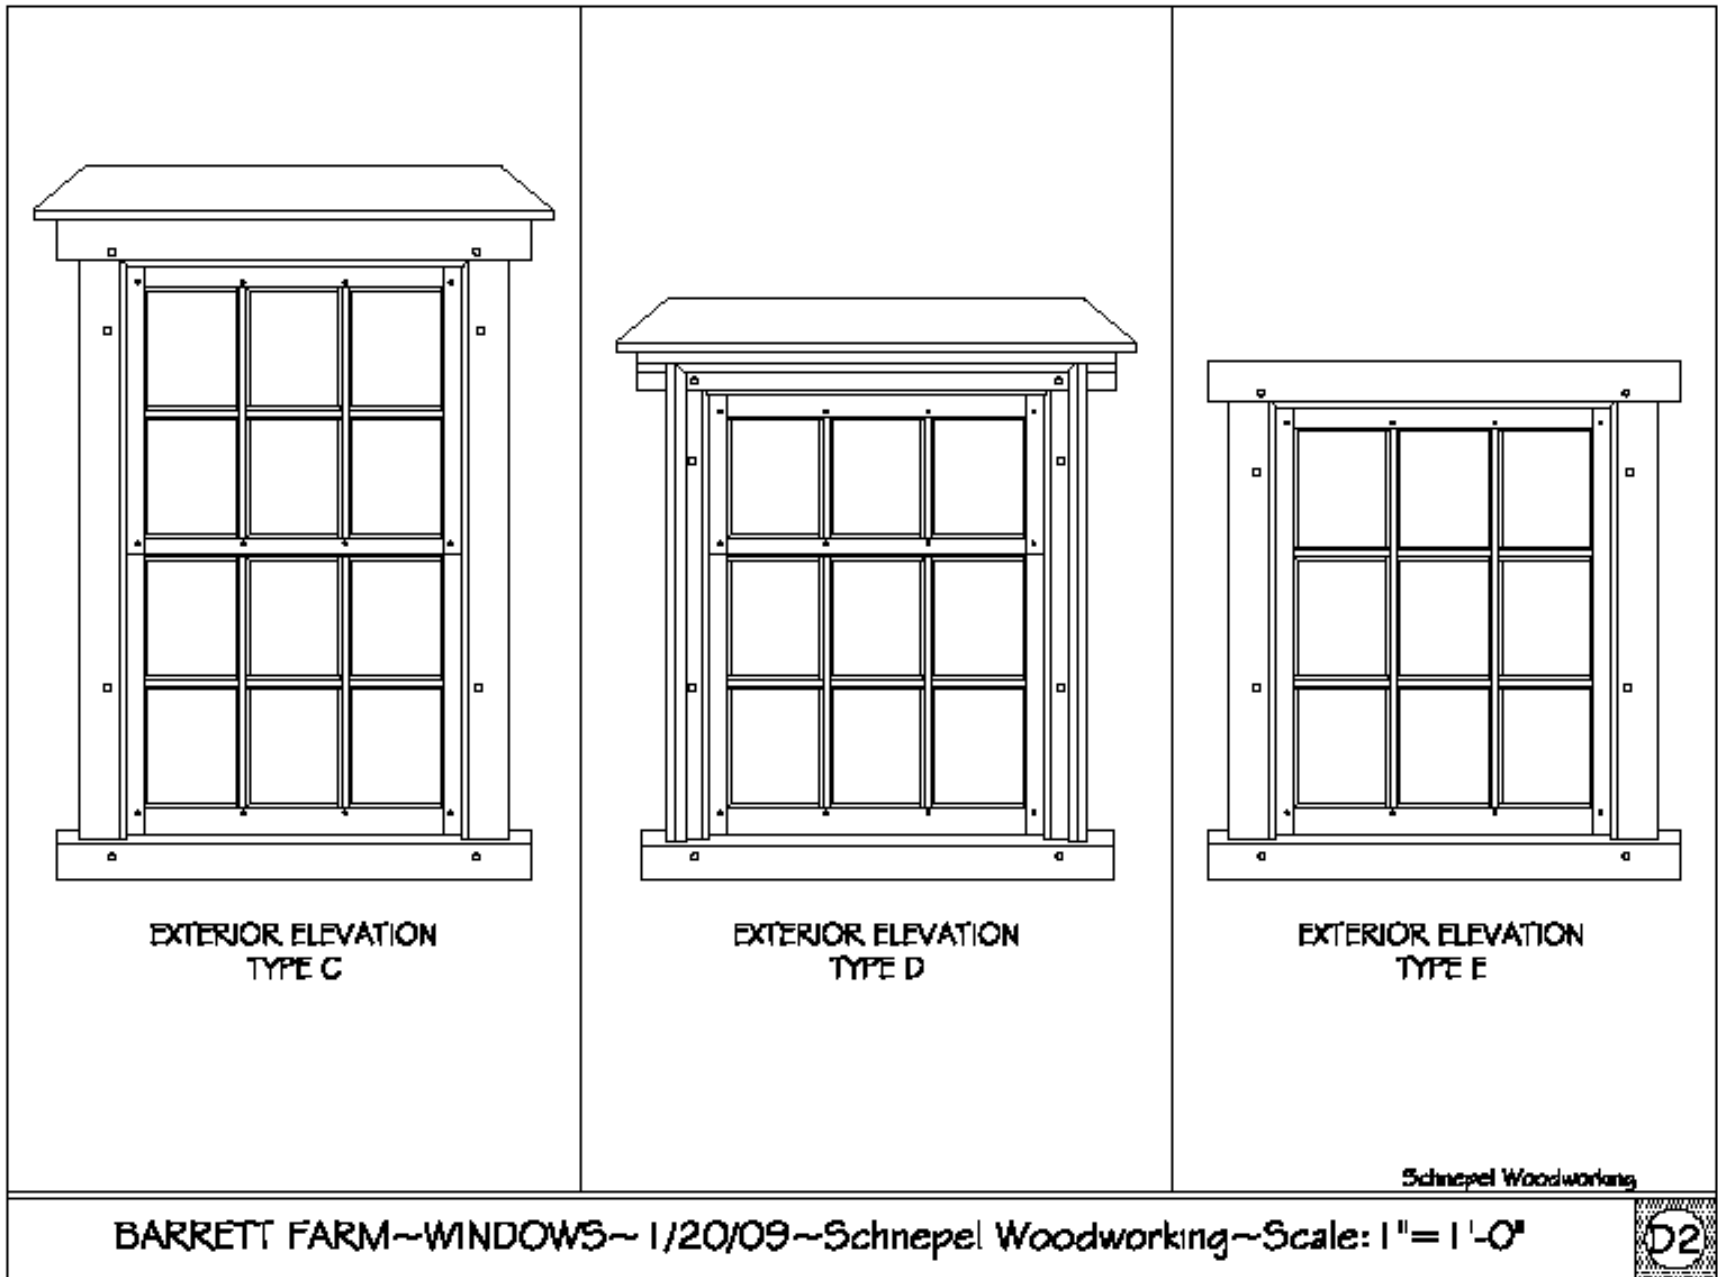


Figure 26 Window Drawing D2 - Types

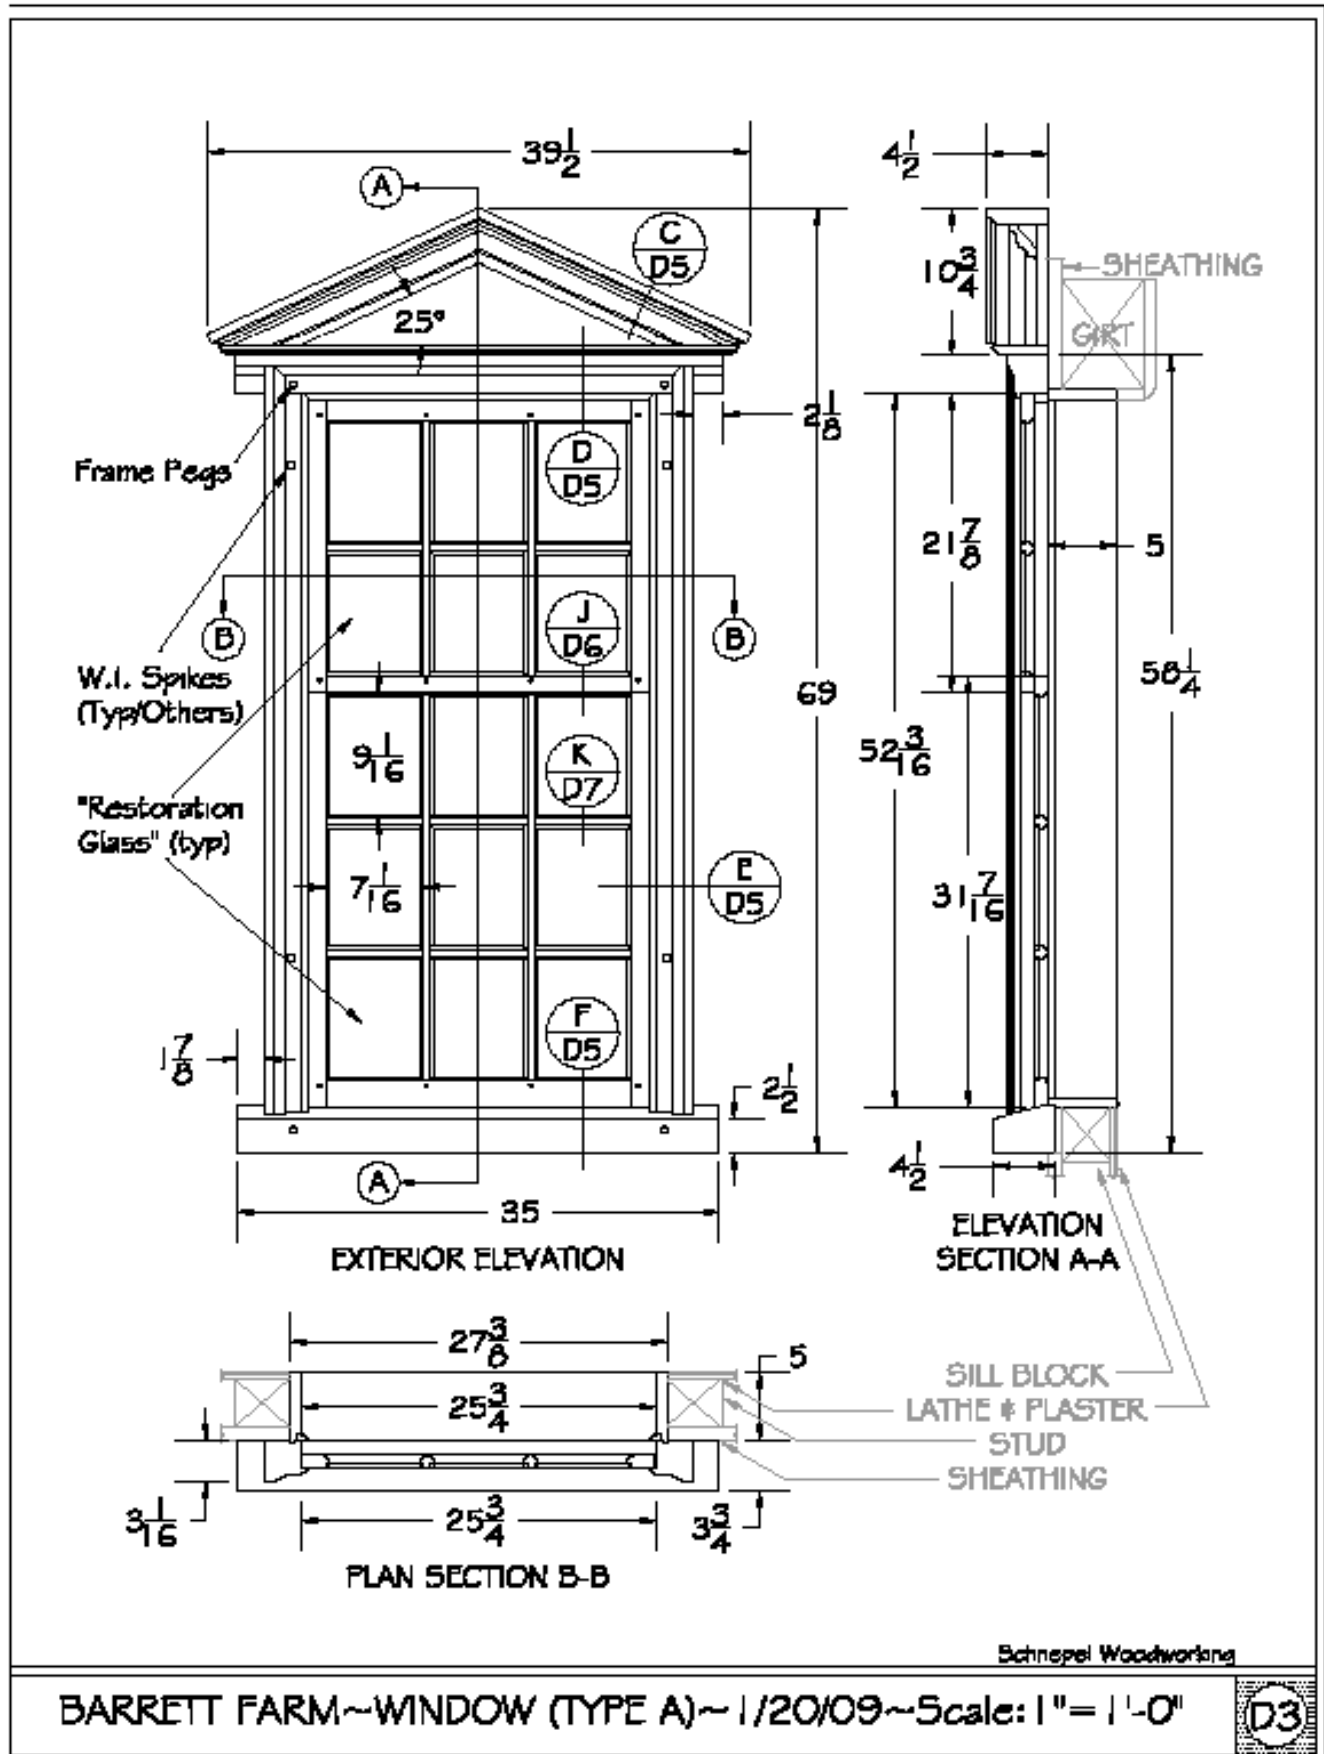


Figure 27 Window Drawing D3 – Type A

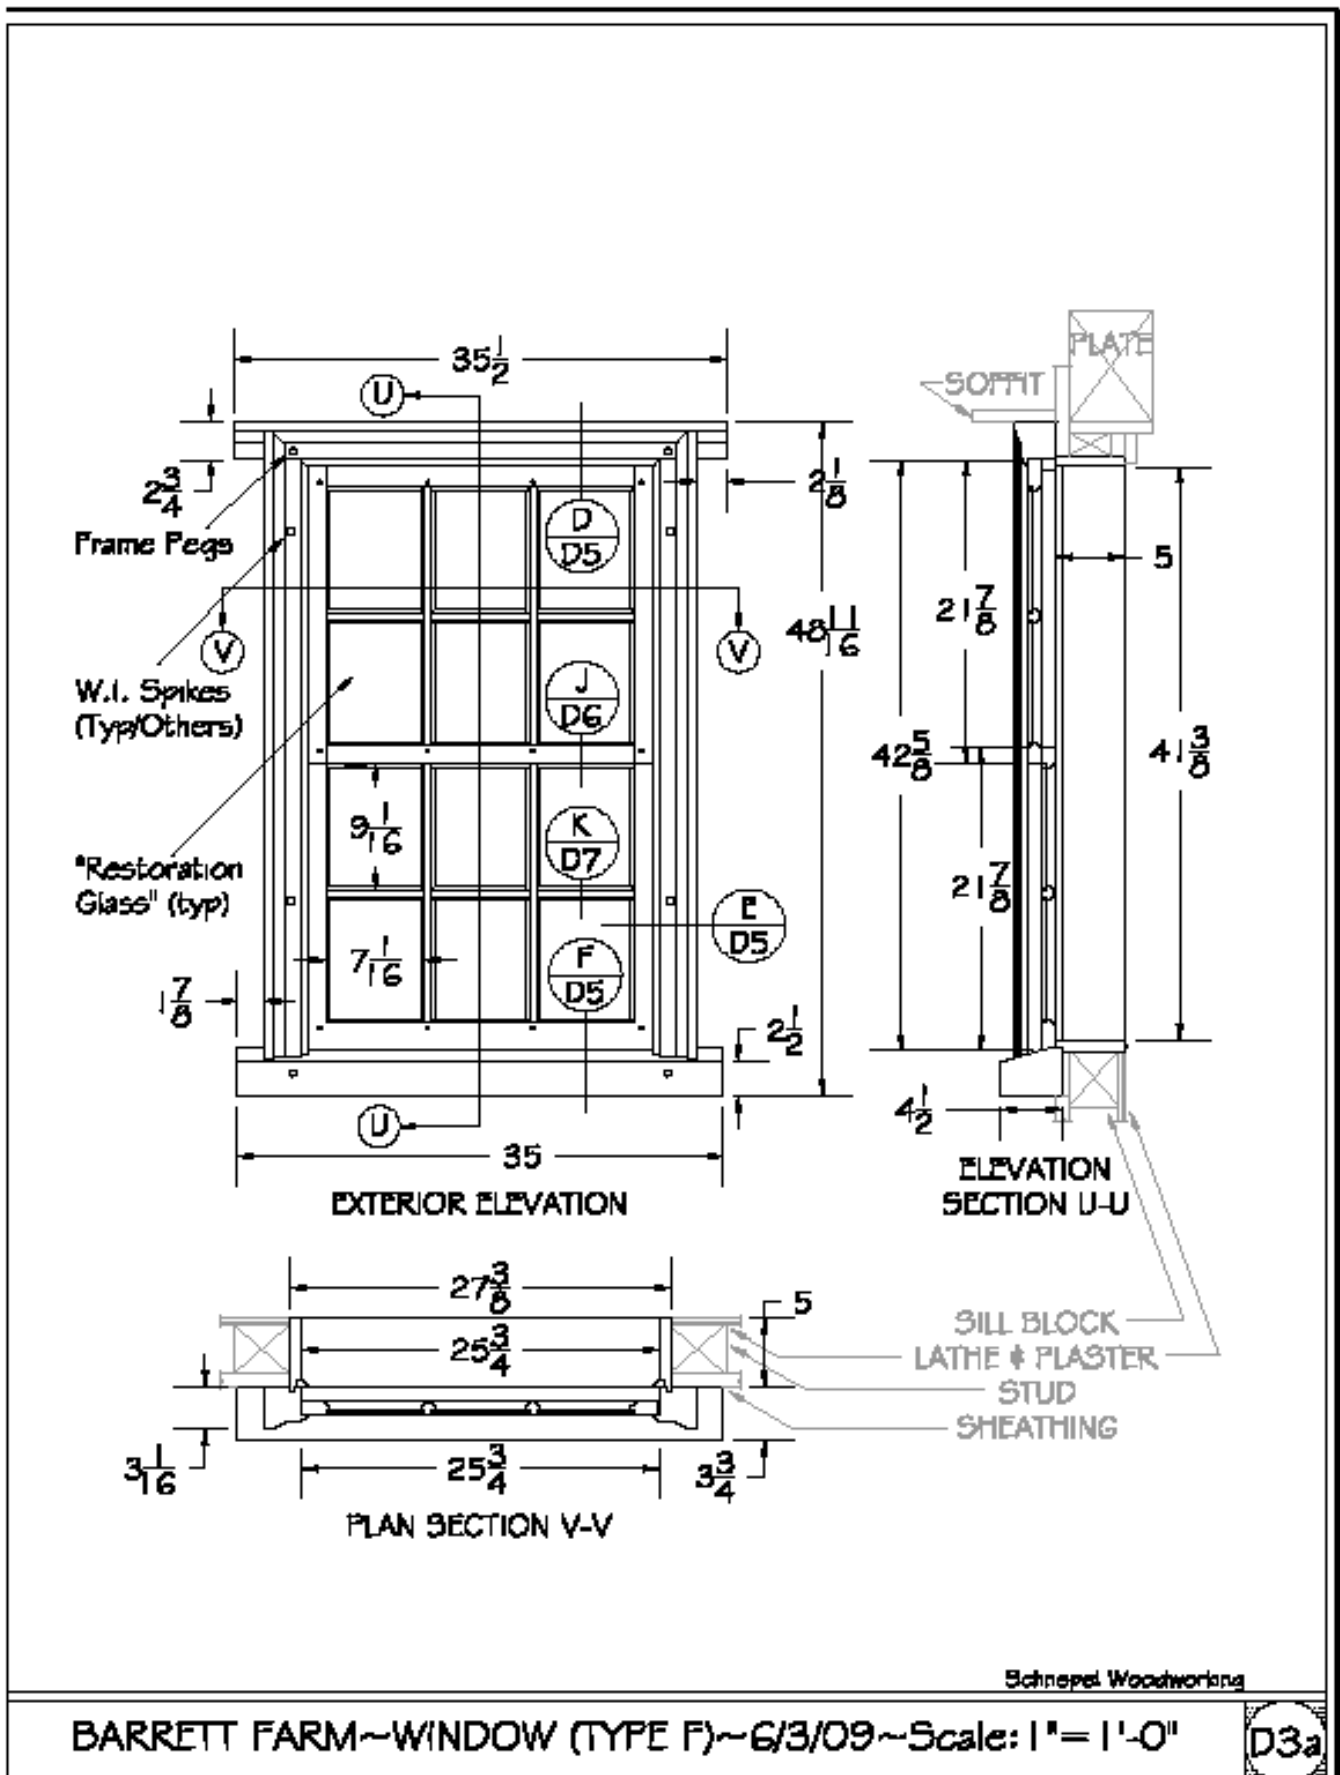


Figure 28 Window Drawing D3a – Type F


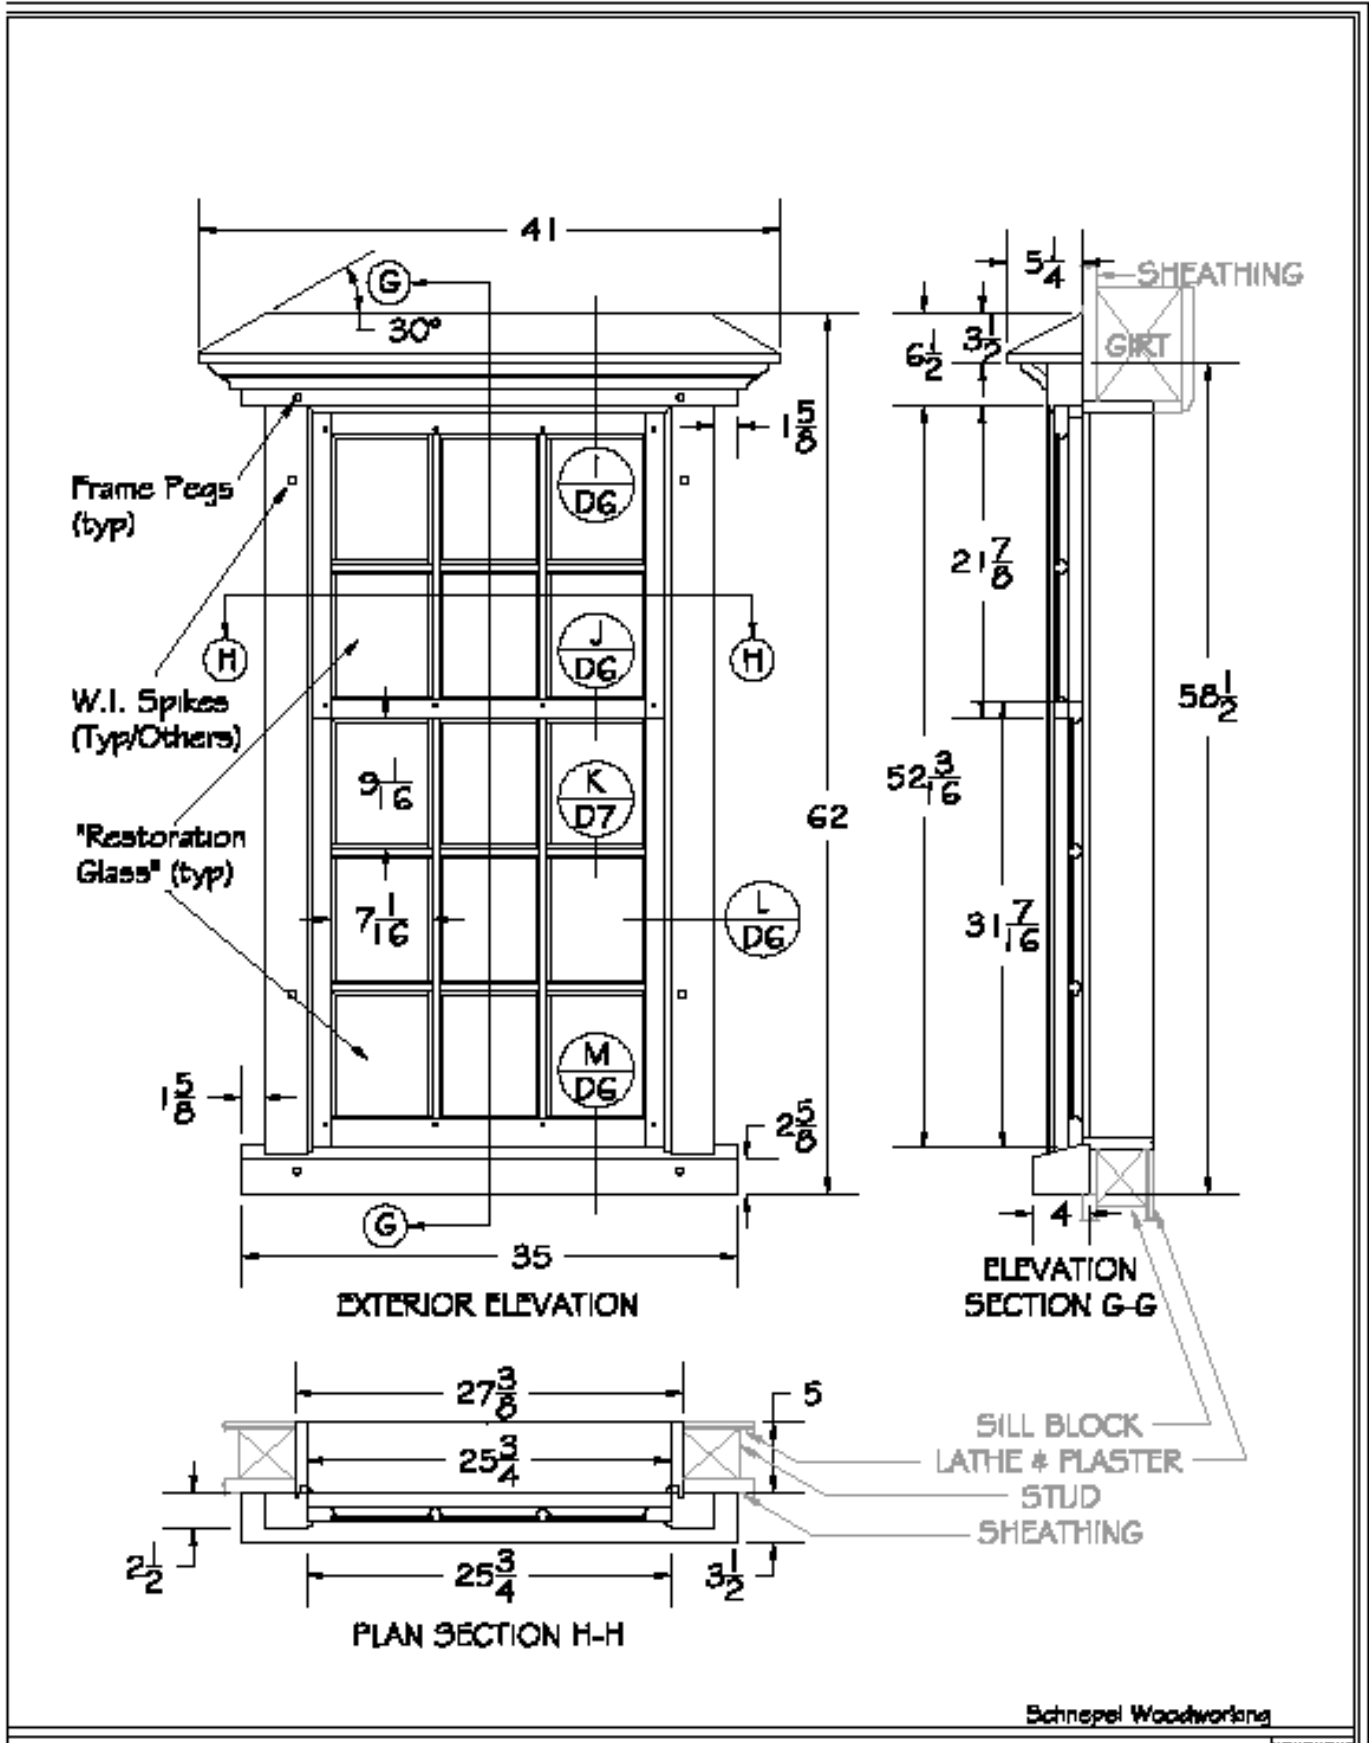


Figure 29 Window Drawing D4



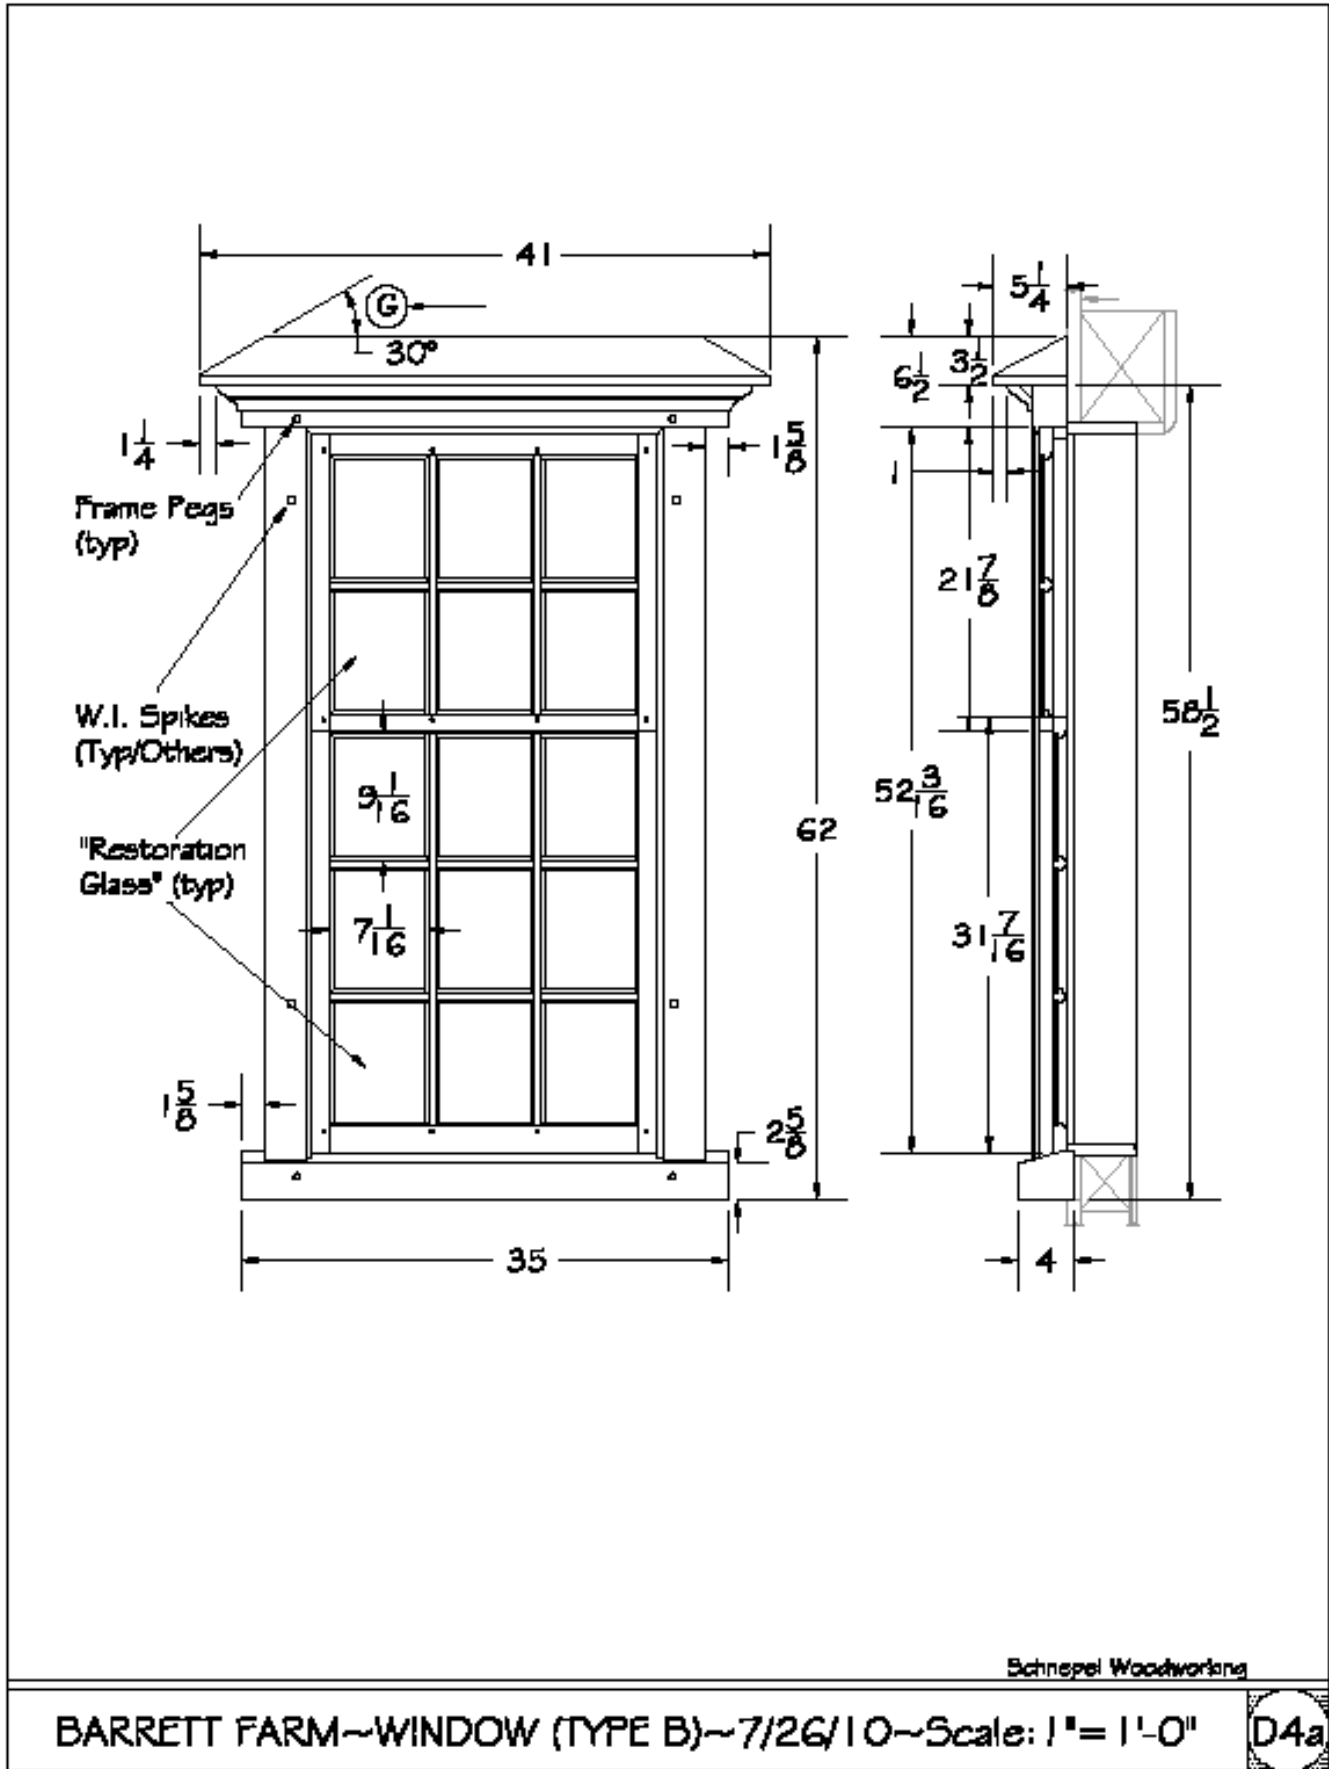

BARRETT FARM~WINDOW (TYPE B)~7/26/10~Scale: 1"=1'-0"

D4a

Figure 30 Window Drawing D4a – Type B

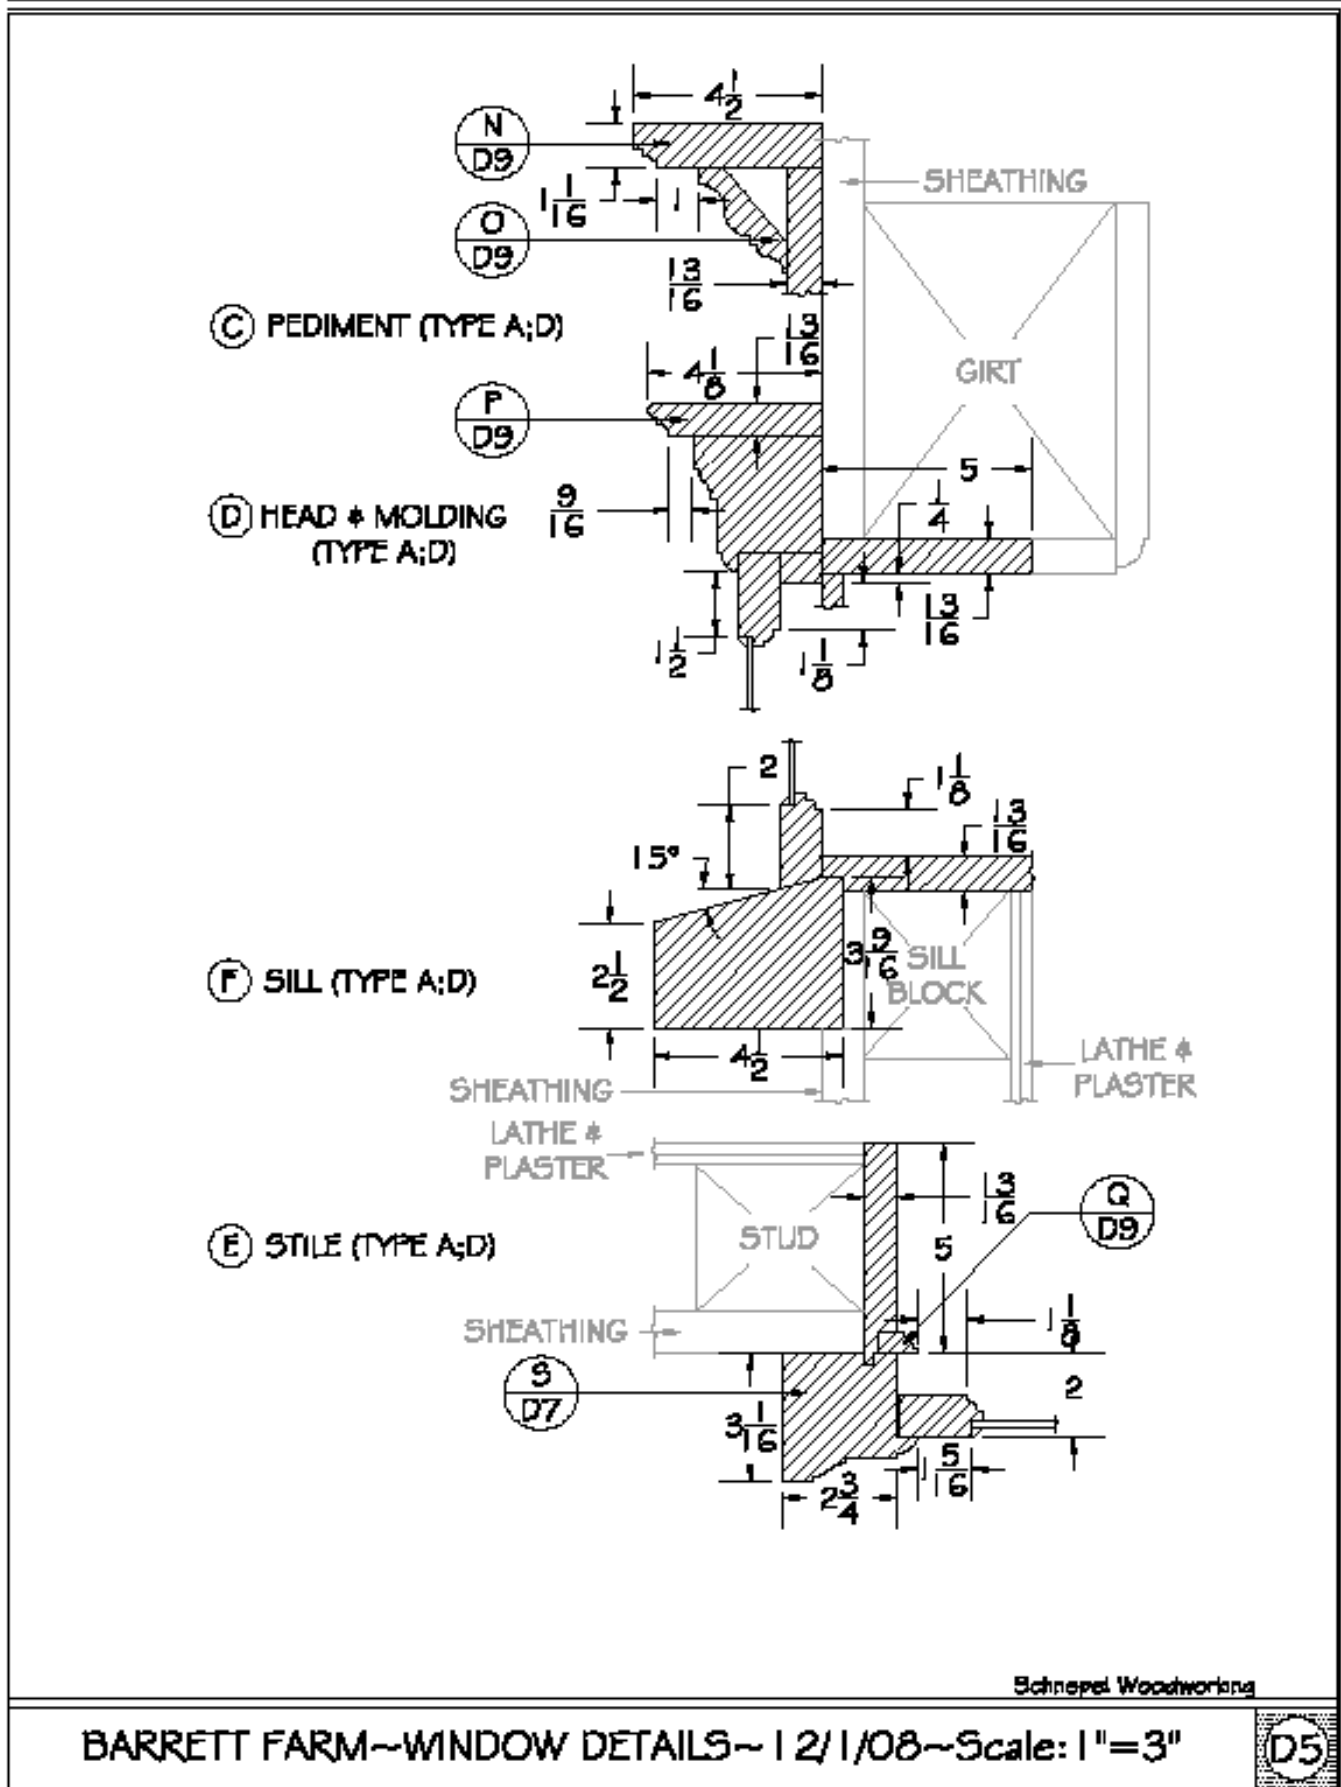


Figure 31 Window Drawing D5 – Cross Sections

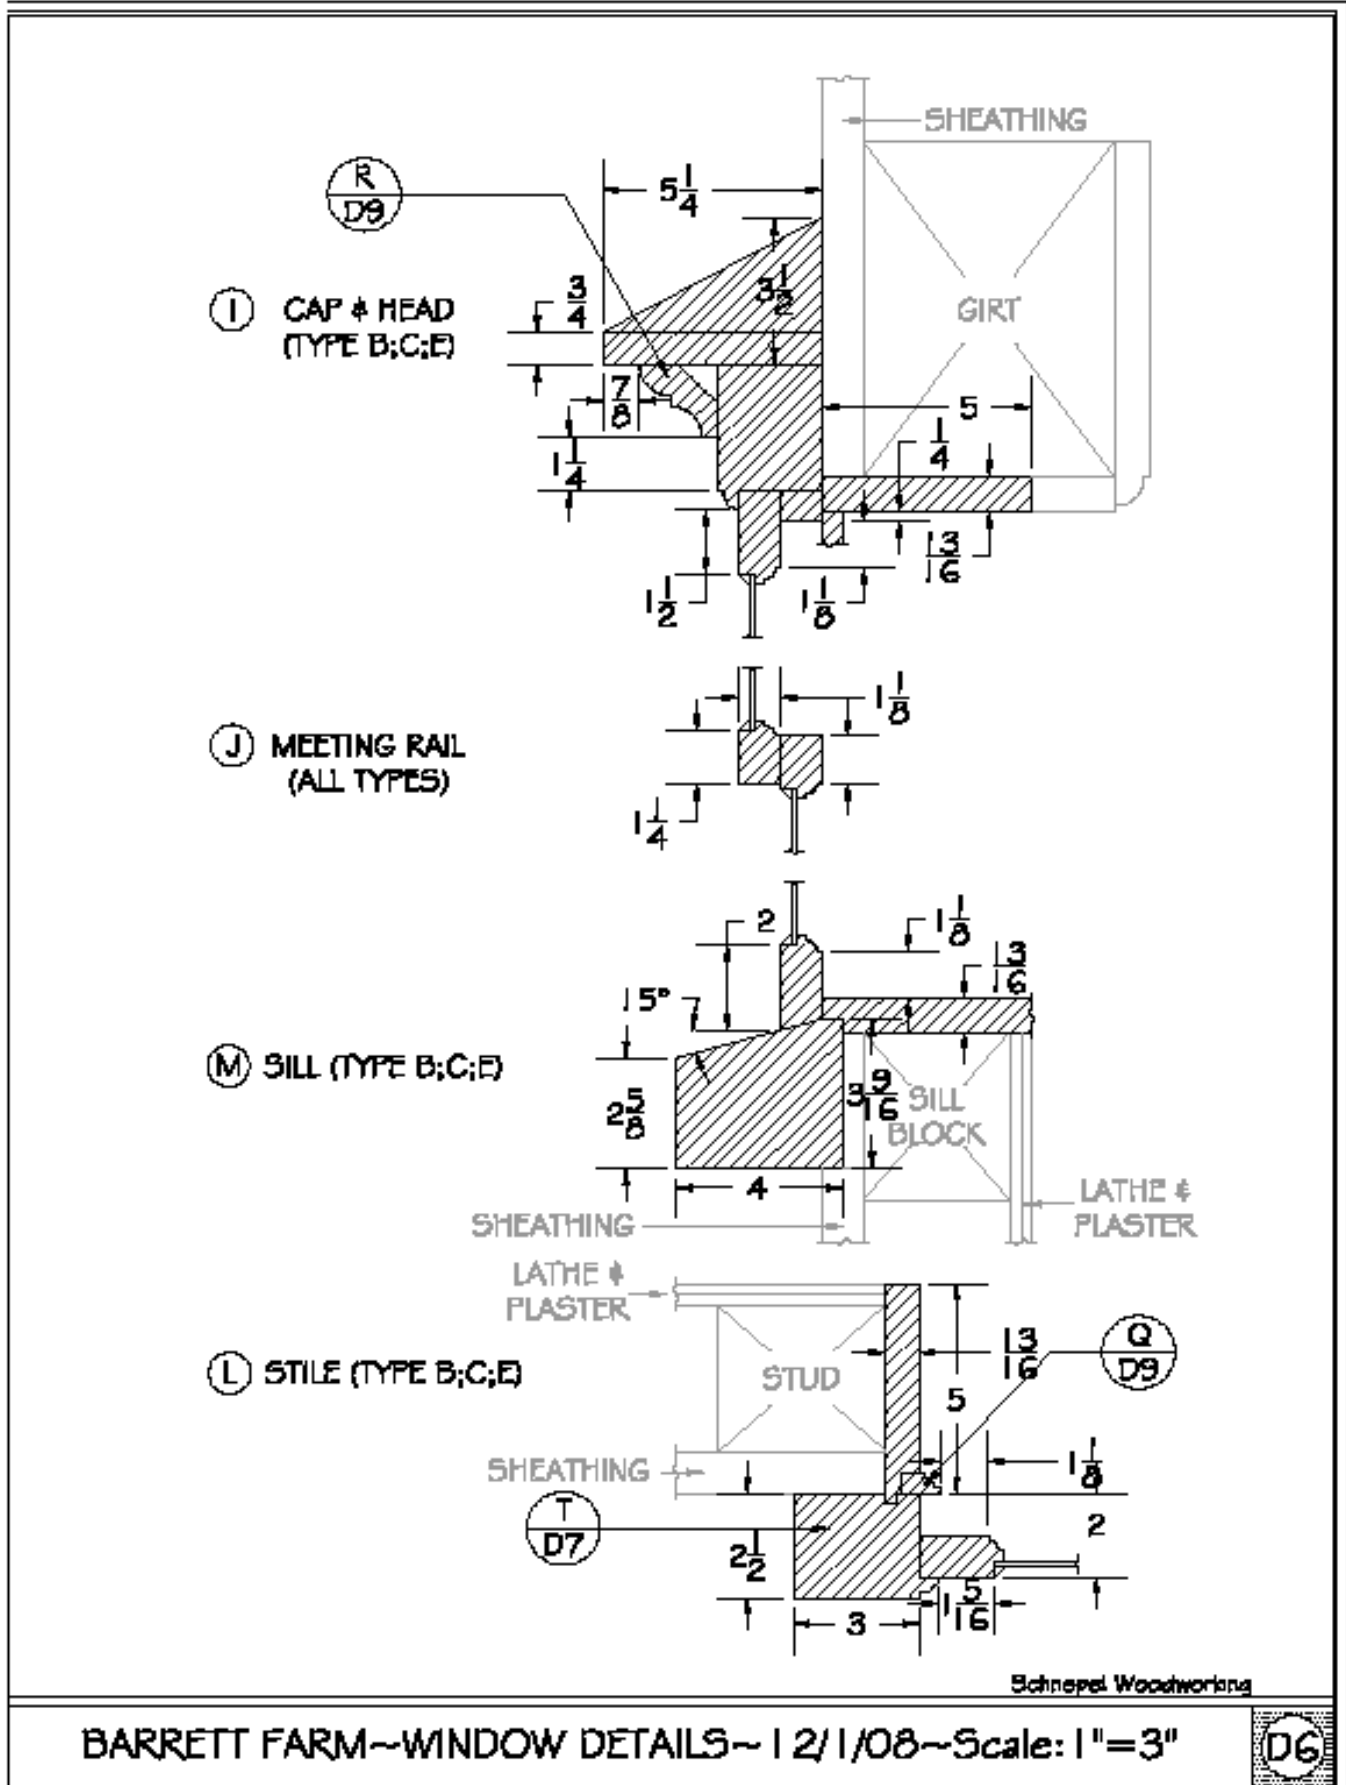


Figure 32 Window Drawing D6 – Section Types



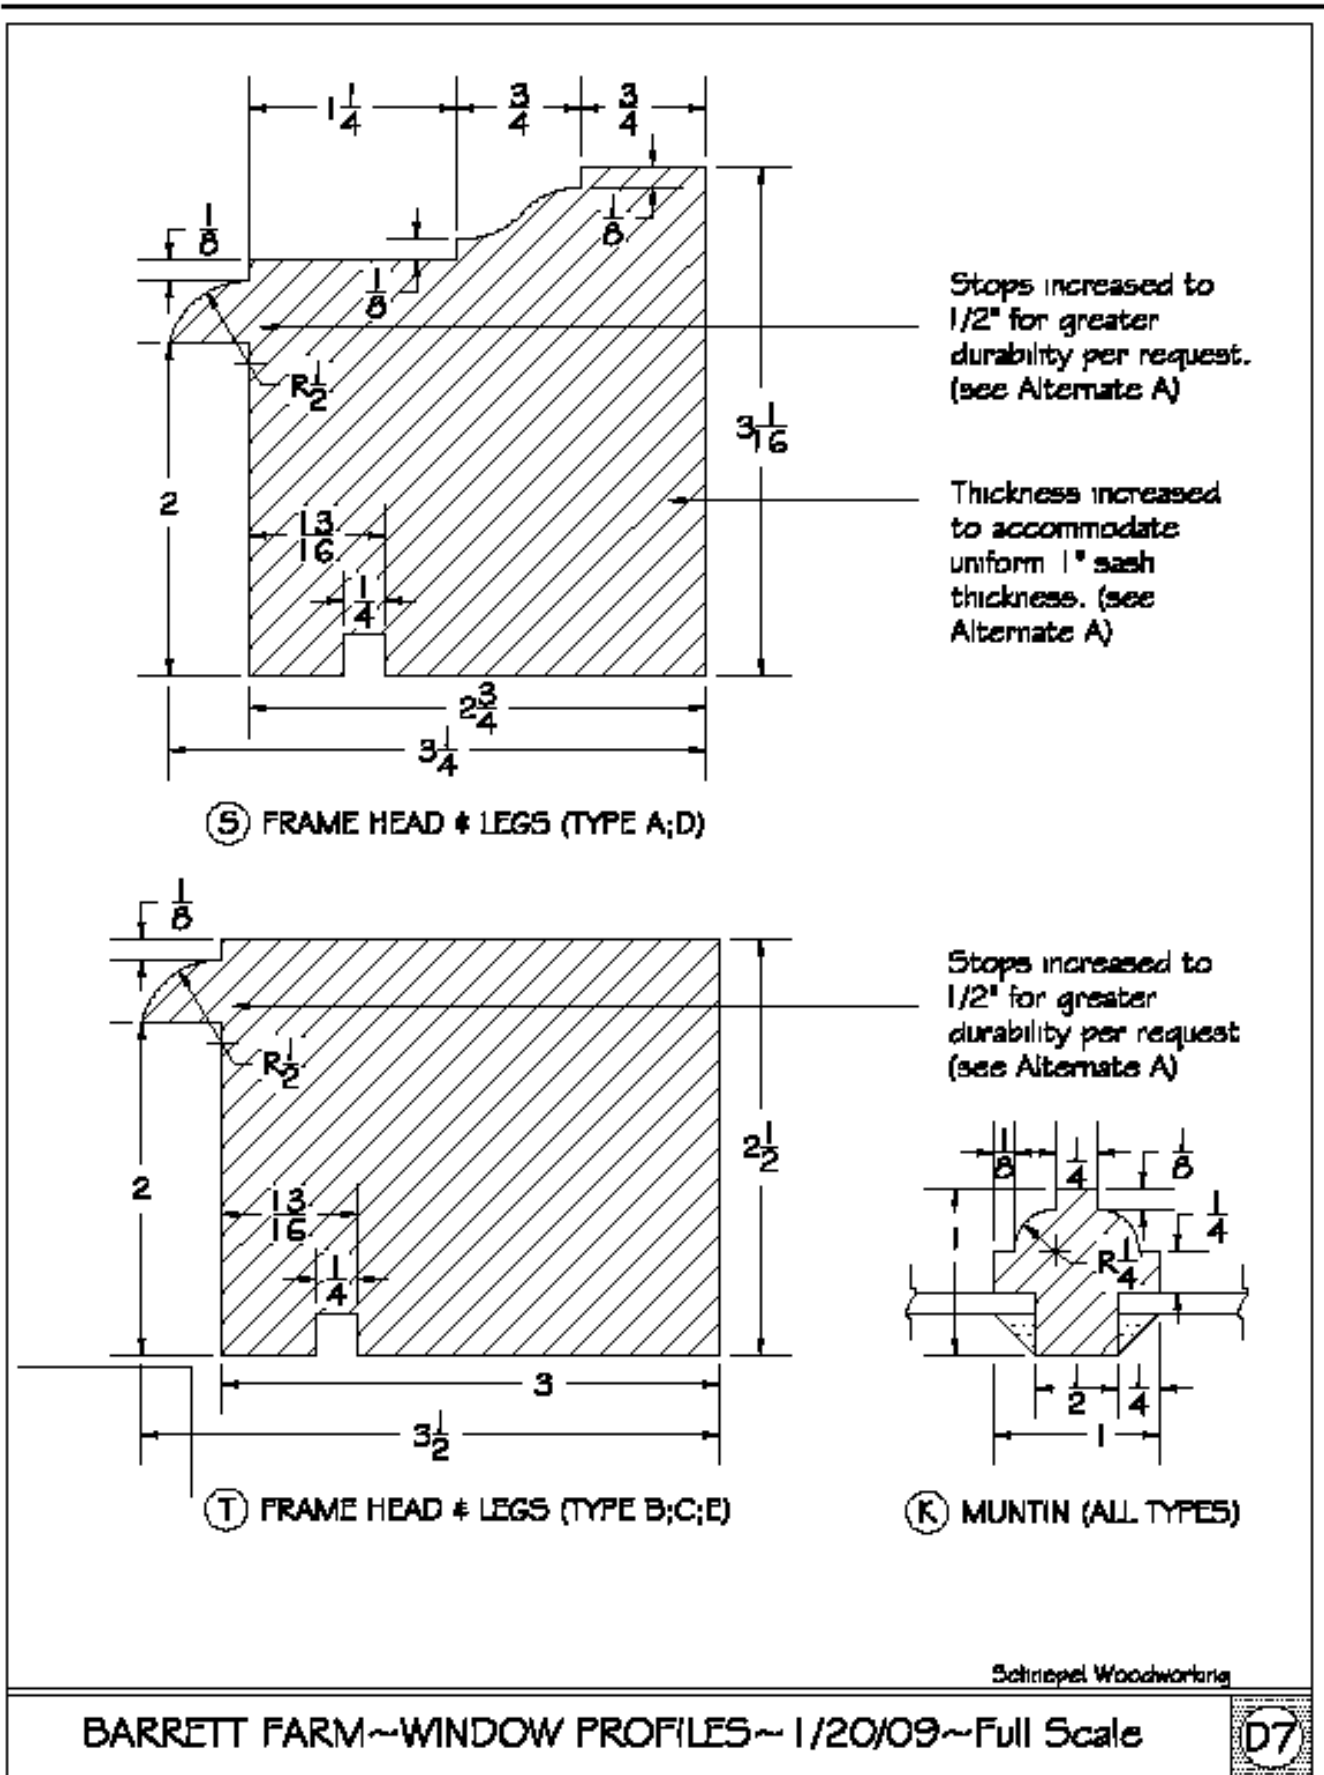


Figure 33 Window Drawing D7 – Window Profiles

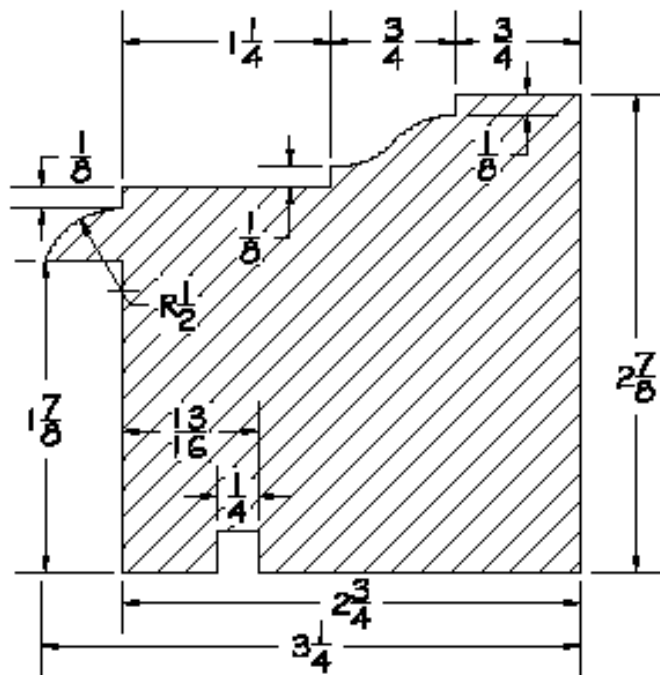

FRAME HEAD & LEGS (TYPE A;D)  
ALTERNATE A

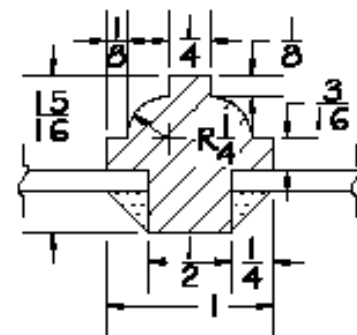

MUNTIN (TYPE A;D)  
ALTERNATE A

This Frame detail most closely approximates the "original" sample which was used as blocking for later window replacements (Attic- east elevation).

This Muntin detail has been borrowed from "The Buckman Tavern; Survey #MA-547;HABS; Transom". Its thickness (1 5/16") has been reduced to fit the Frame as drawn.

Schrieppel Woodworking

BARRETT FARM~WINDOW (ALTERNATE A)~ 1/20/09~Full Scale

D8

Figure 34 Window Drawing D8 – Alternate A

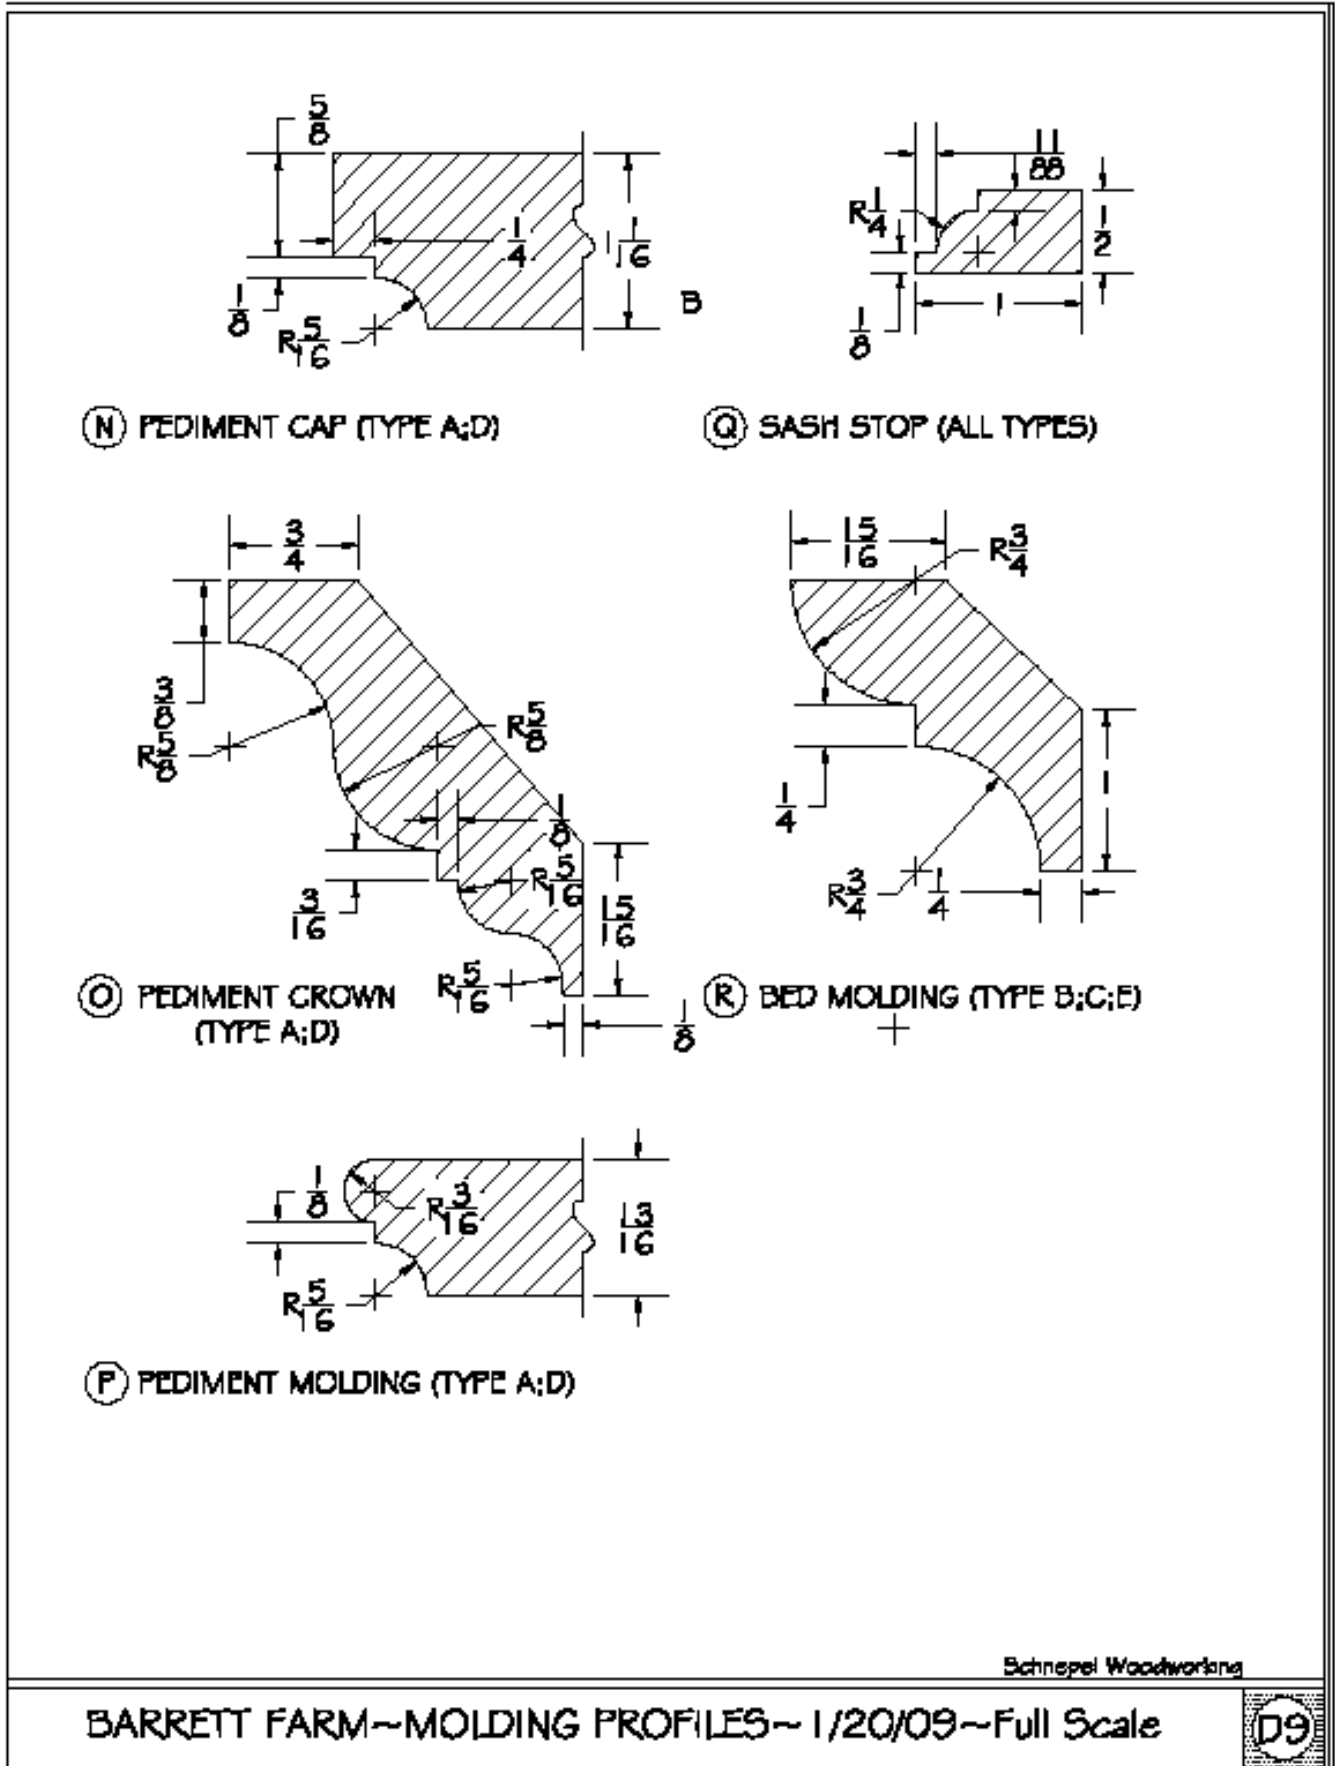


Figure 35 Window Drawing D9 – Molding Profiles

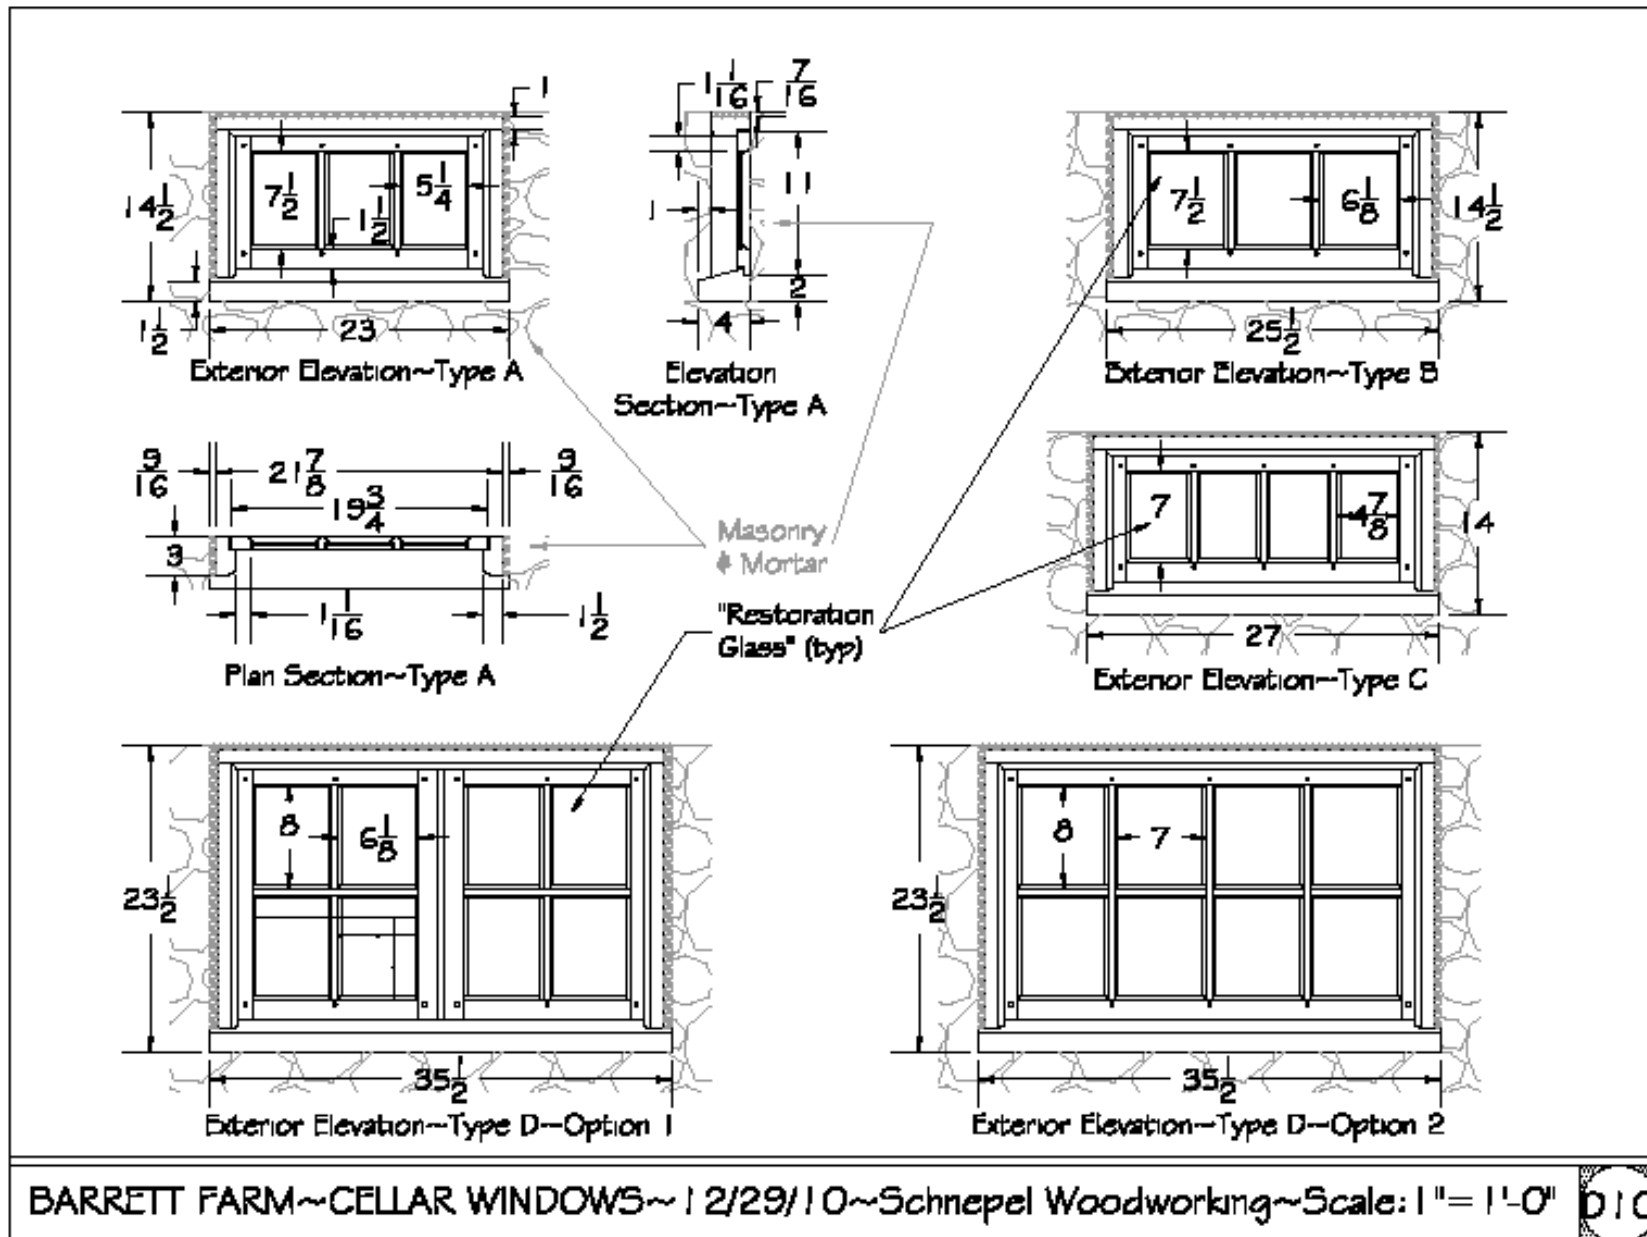


Figure 36 Window Drawing D10 – Cellar

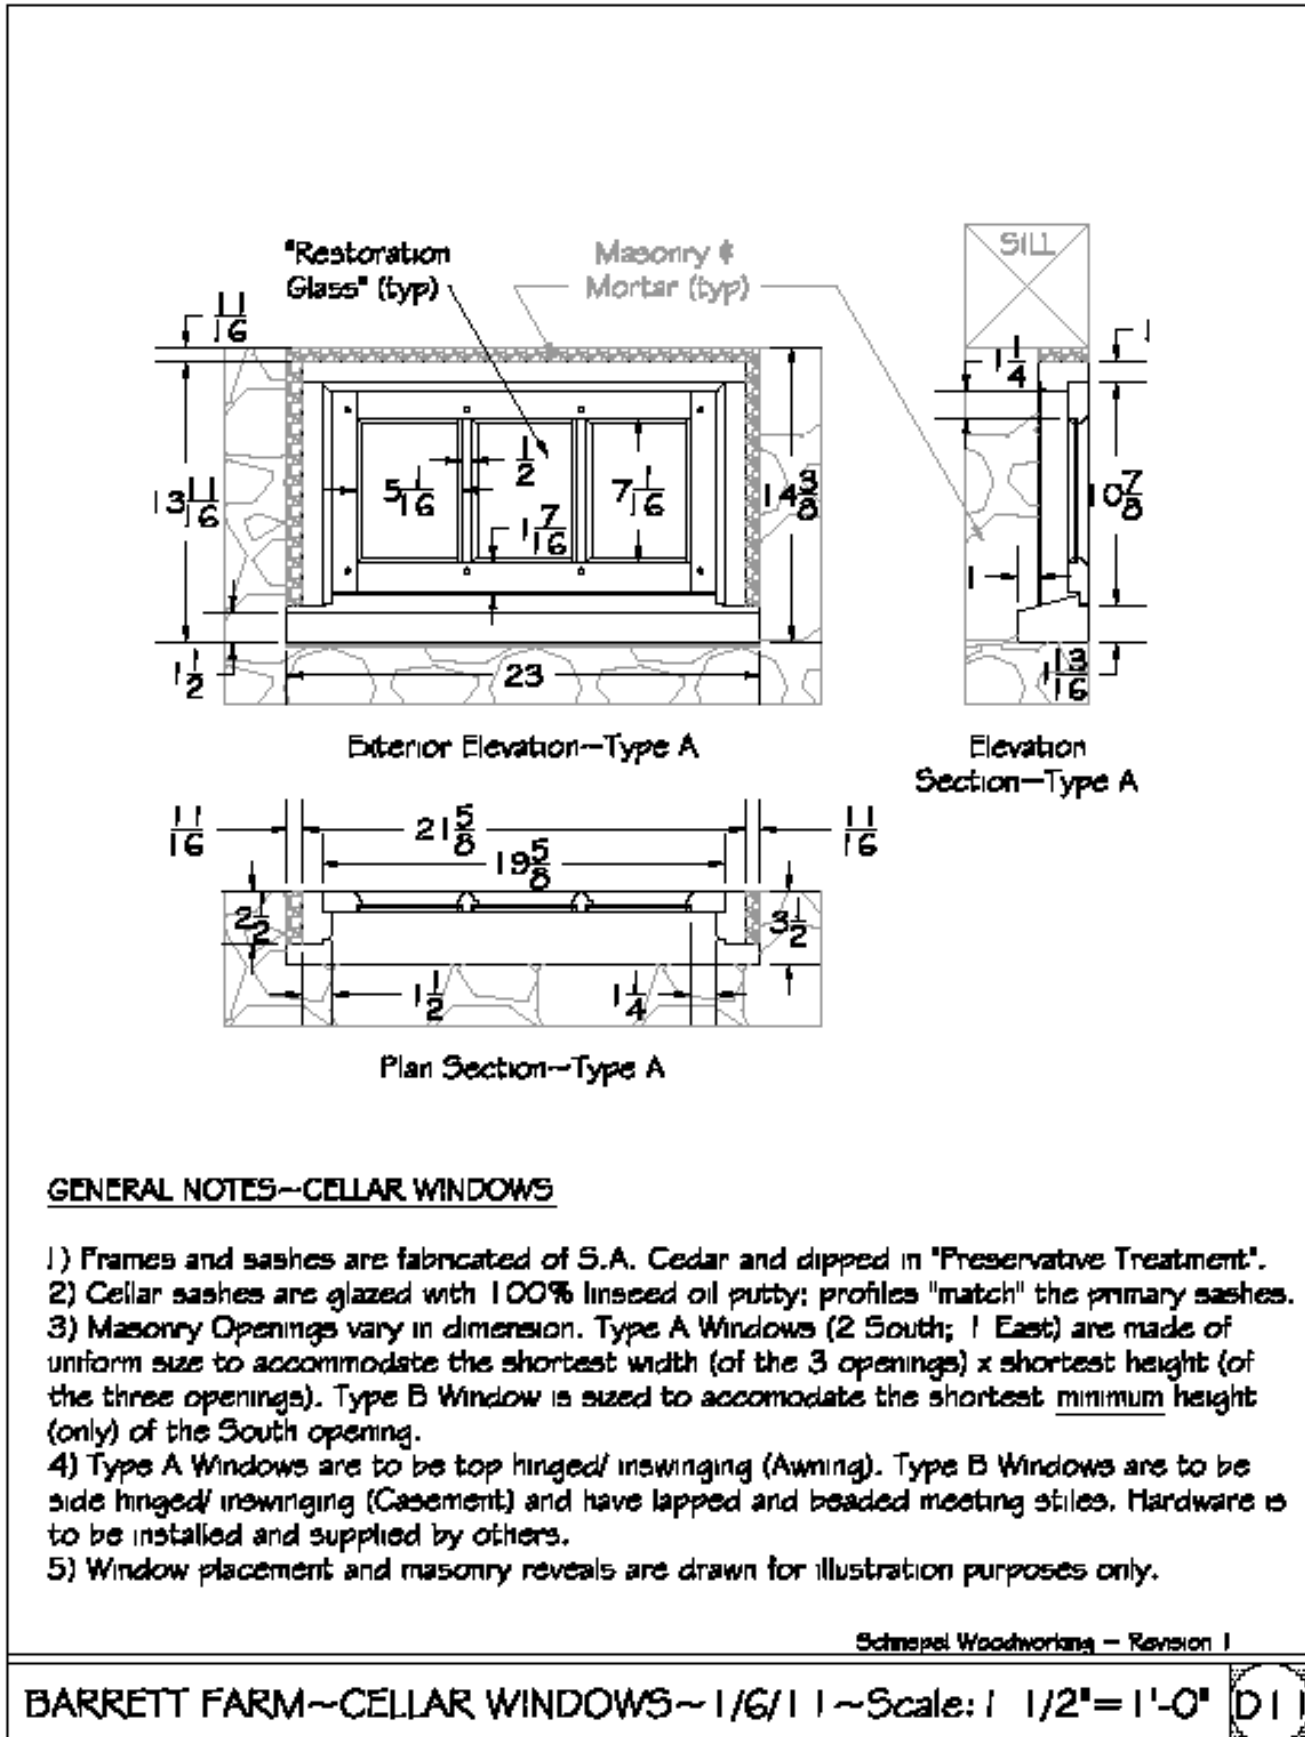


Figure 37 Window Drawing D11 - Cellar



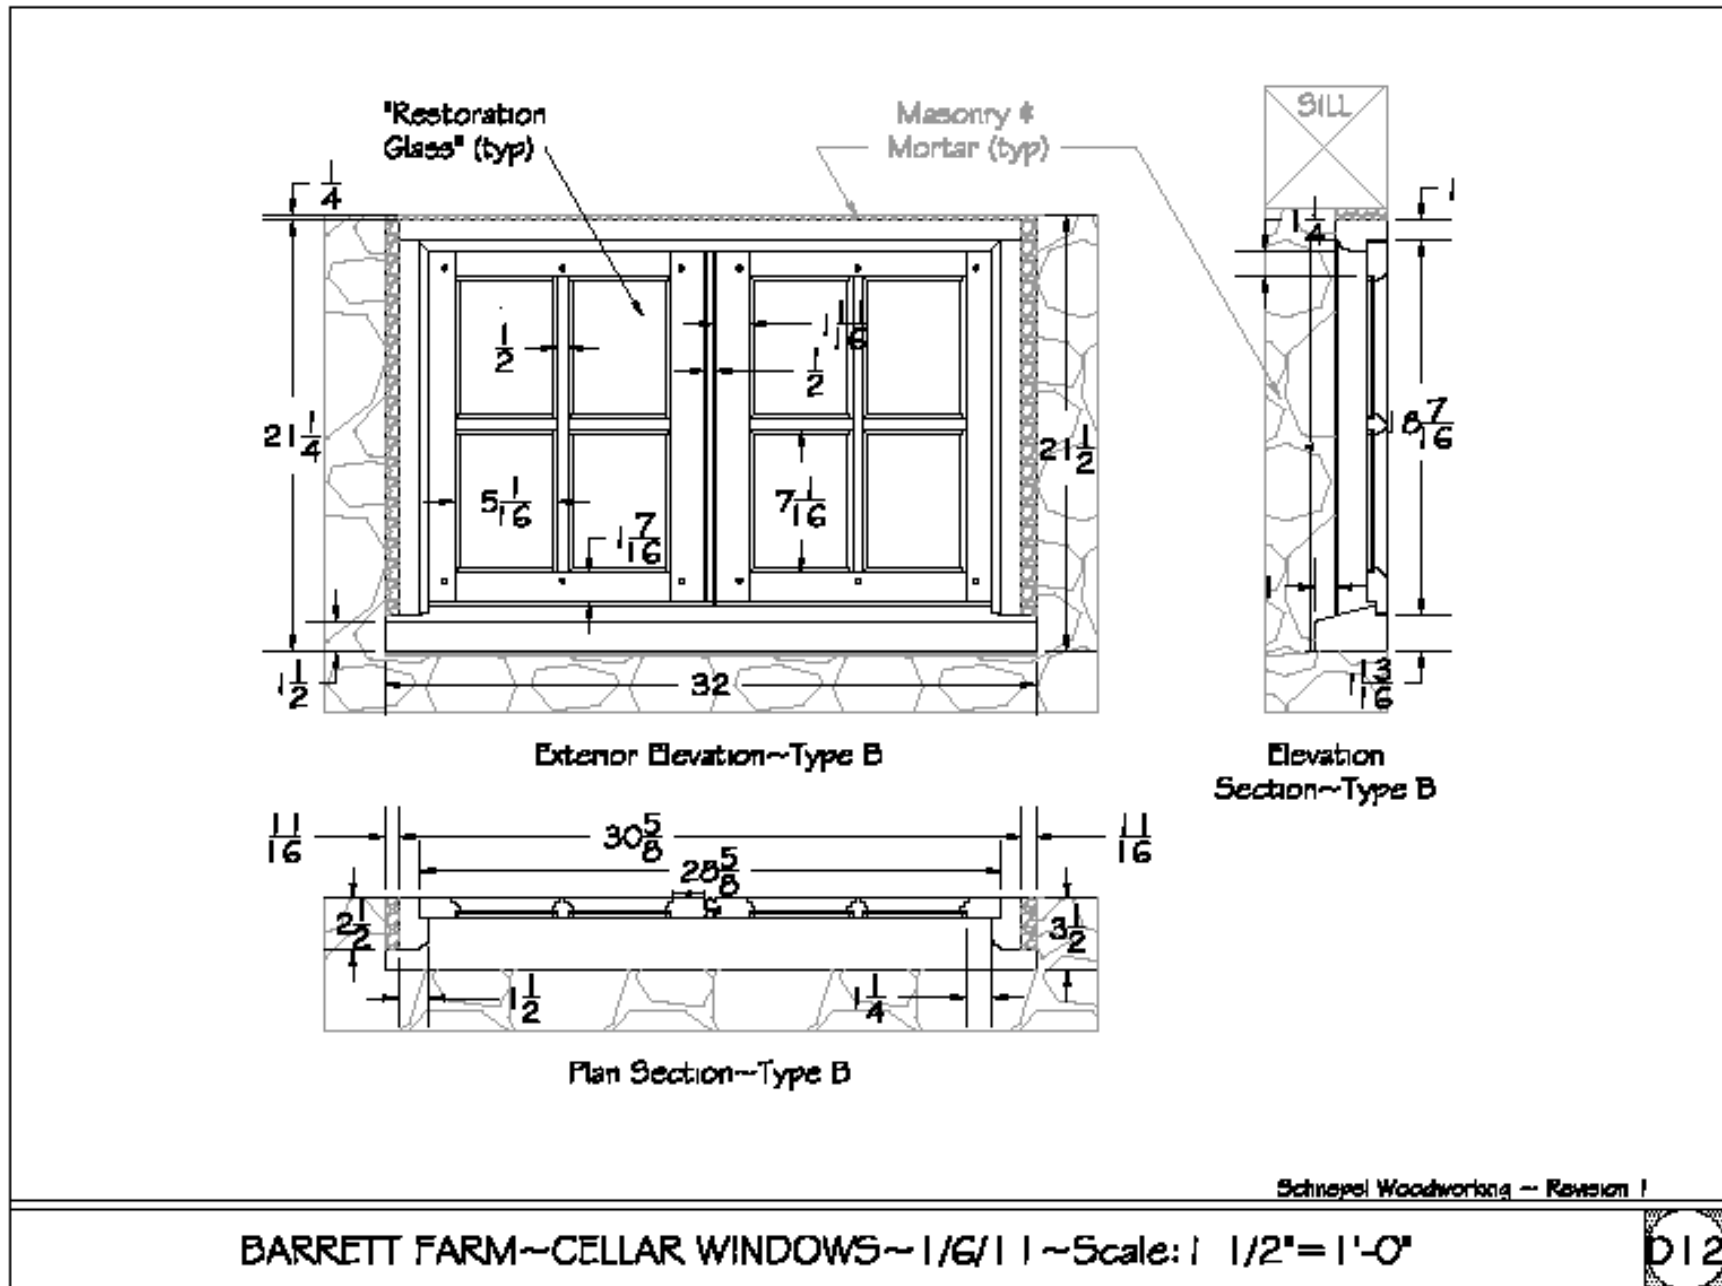


Figure 38 Window Drawing D12 - Cellar

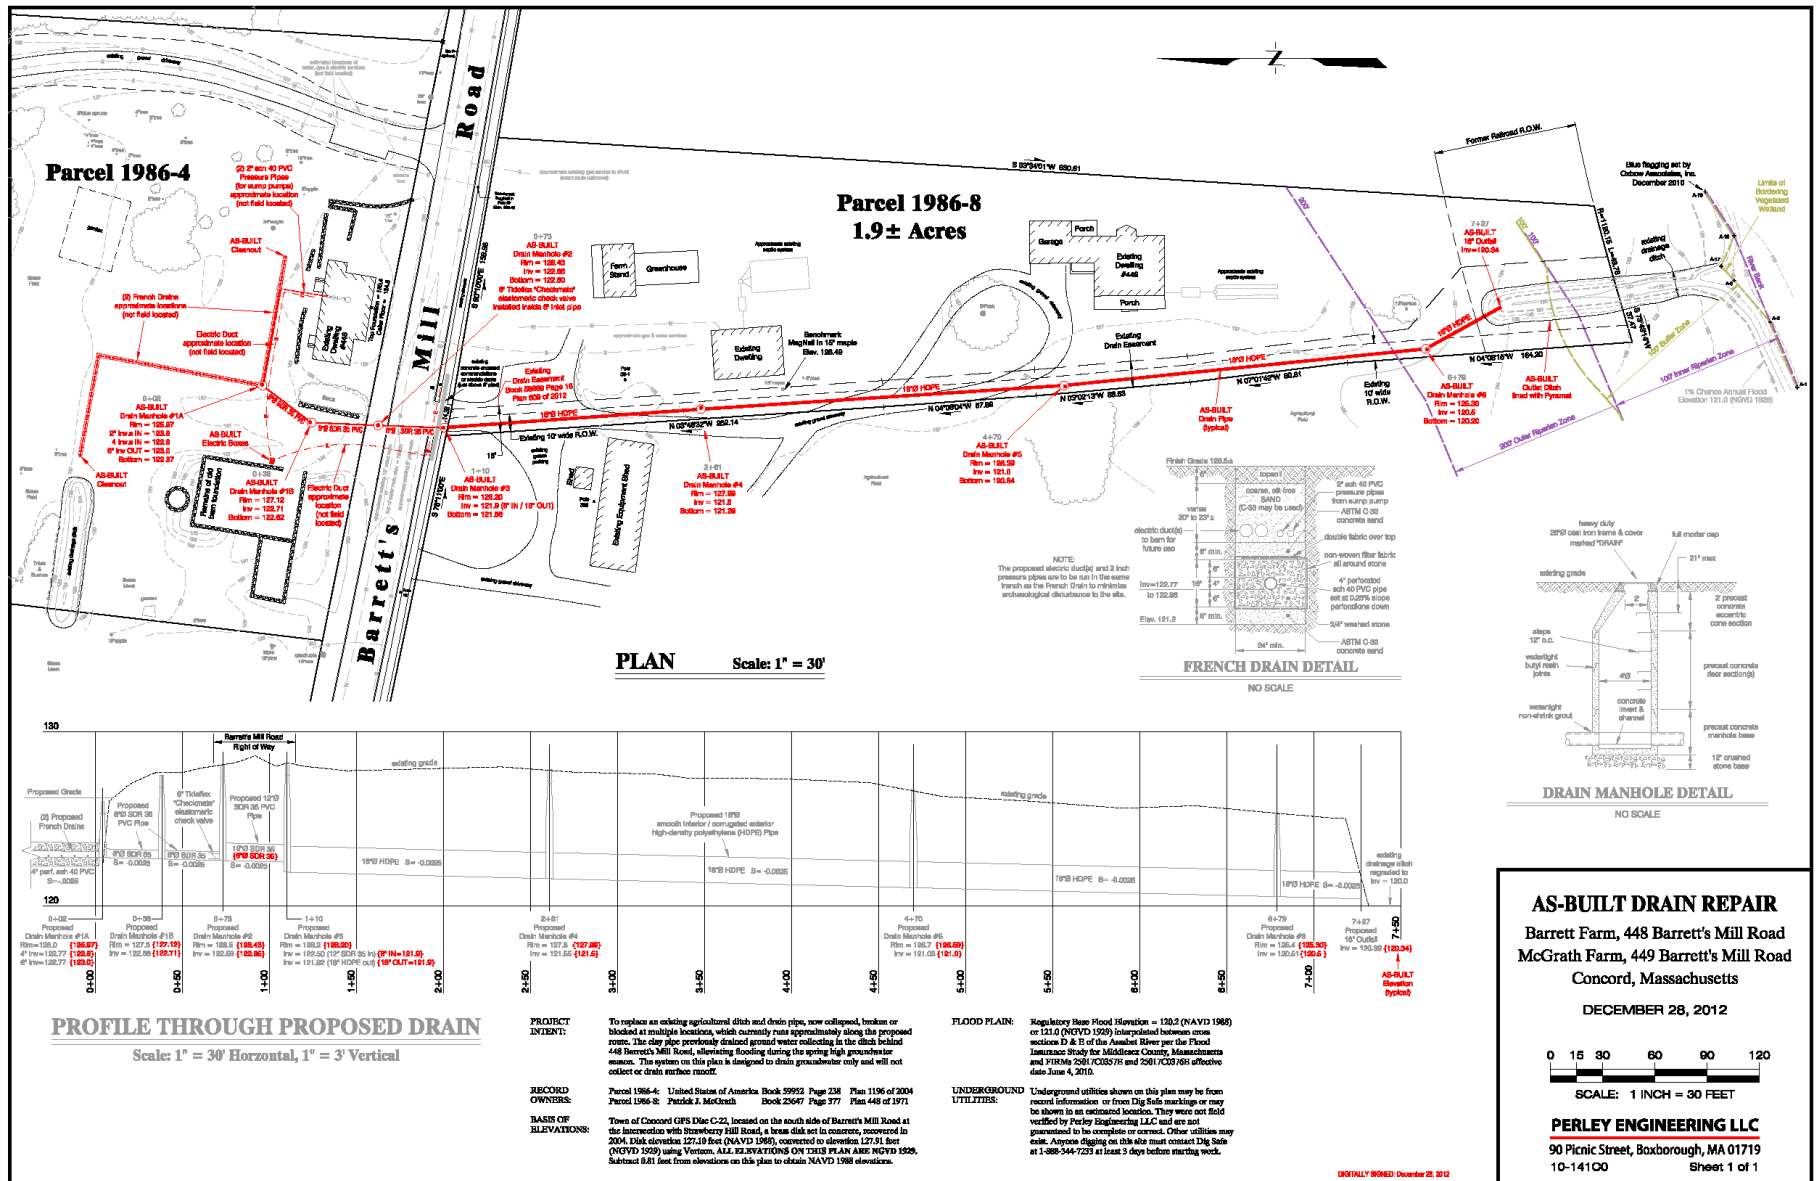


Figure 39 Drainage – Layout and Profile



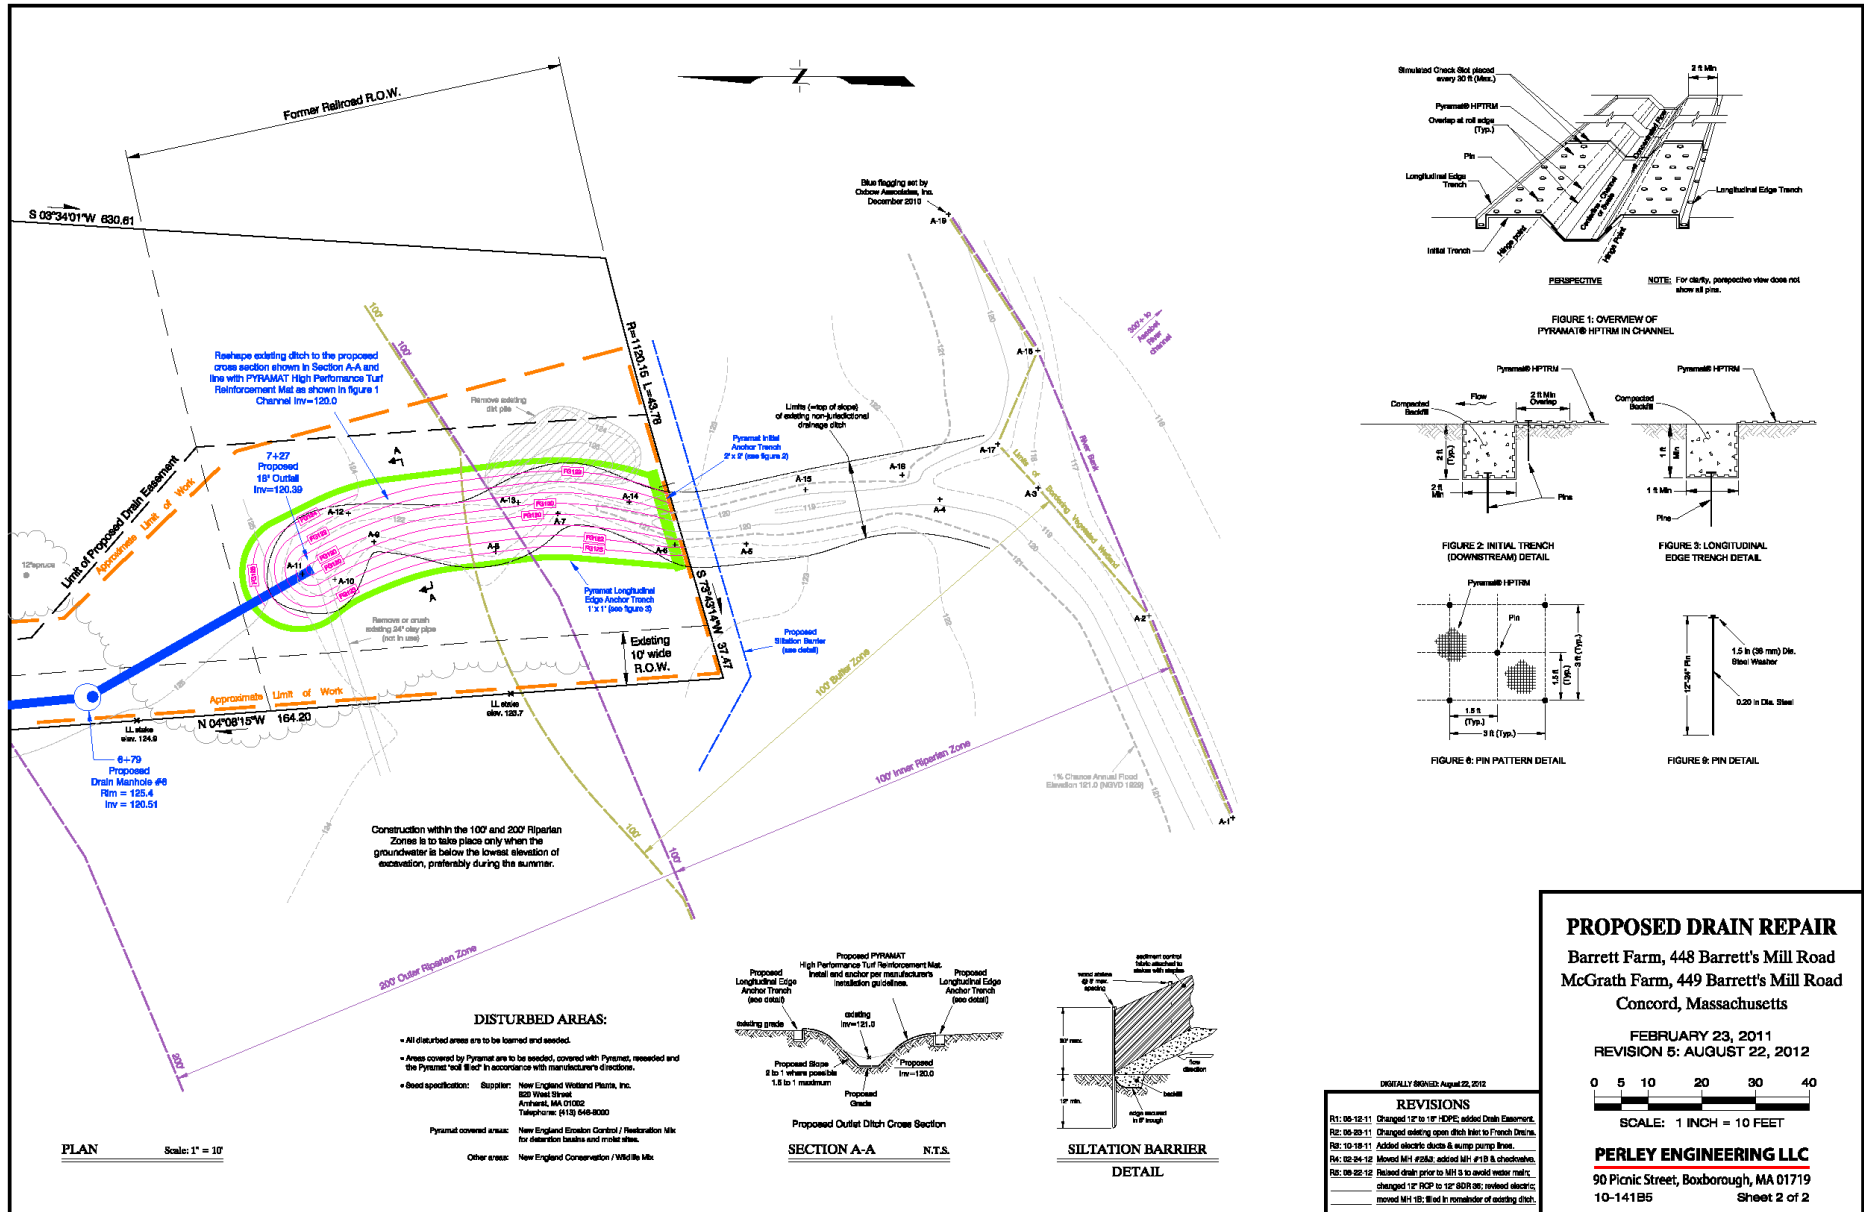


Figure 41 Drainage – Ditch Detail